
P

SURVEY FOR

W.A.WHITELAW

LOCATED IN BLOCK Nº I MOREY'S ADD.
TO MEDFORD AUG. 1952

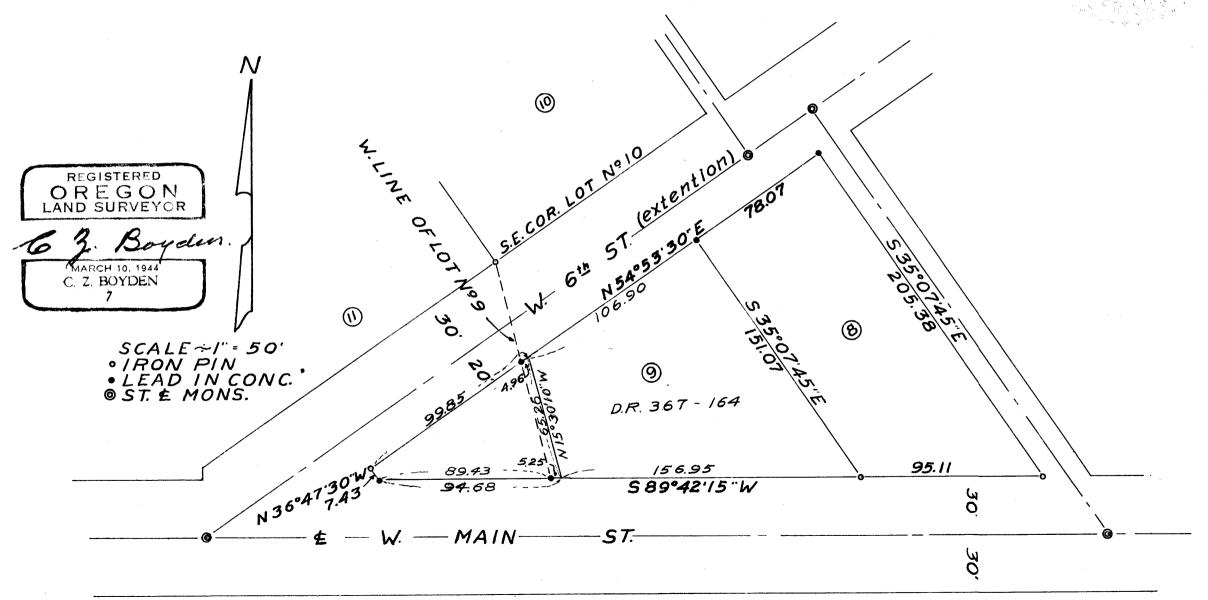

Survey Narrative to comply with Section 87-330, Oregon State Law, 1947

Survey No. 477

For: W. A. Whitelaw


Purpose: To establish the boundaries of that portion of Lot No. 11 of Morey's Addition to Medford which is located between the extension of West 6th Street and West Main Street, also to determine and describe a new boundary between the W. A. Whitelaw property and the Shell Oil Company property, which line would clear the present improvements from encroachments.

From the controls for the location of lots in Morey's Addition as determined, established and reported in records of surveys in the Jackson County Surveyor's Office, Survey No. 444, located the southwest corners of Lot No. 10 and the southeast corner of Lot No. 11 and a line between these two corners for the easterly boundary of that portion of Lot No. 11 required. The remaining boundaries are established along street boundaries determined from the official street center-line monuments.

Since this easterly boundary of Lot No. 11 passed through present buildings, a new boundary was established as directed by moving the northerly end of said line 4.96 feet easterly along the southerly boundary of West 6th Street and the southerly end of said line 5.25 feet easterly along the north boundary of West Main Street, and new descriptions were prepared for each tract.

August 20, 1952



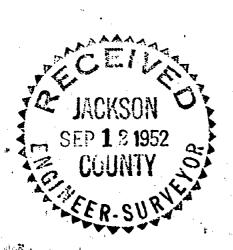

*3*0 *30*' 11:56 **©** W.LINE OF LOT Nº 9 **3**0 W.A. WHITEL LOCATED IN BLOCK NOI TO MEDFORD 0 SURVEY I.A. WHIT V CONC. REGISTERED OREGON LAND SURVEYOR 446