


NW Cor. D.L.C. 66  
Belt with 1/2" head found

Survey for Thomas E. Whittle  
In D.L.C. 66, T 37S, R 2 W, W.M. Jackson County, Ore.  
Bearings from Solar Observations  
Survey completed Sept. 7, 1952.

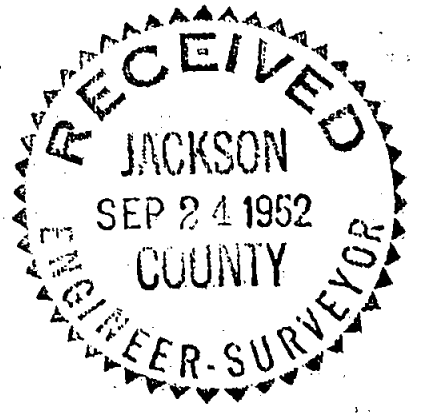

30° 04' 23" W 2678.71  
Record 2677.62

56.6  
Sandstone with cross found

303.58

existing fence

Scale 1" = 100'

5/8" x 30" I. Pin set

S 89° 27' E 359.20

5/8" x 30" I. Pin set

S 83° 44' 10" E 267.31

5/8" x 30" I. Pin set

30° 02' 40" W 1028.61

311.59

68.4

N 61° 52' W  
631.21 center of canal

30° 02' 40" W 368.29

5/8" Pin Set  
14.0' N of center ditch

1/2" I. Pipe N.E. Cor. D.L.C. 66 found

D.L.C. 66, T. 37S., R. 2W.  
Sec. 15, T. 37S., R. 2W.

Written narrative to accompany plat for Survey No. 479  
as specified by Oregon Law.

Survey for Mr. Thomas E. Whittle, Central Point, Jacksonville Road.

Purpose of survey, to lay out, stake, and furnish description  
for five acre tract in southwest corner of ranch.

Survey completed September 7, 1952.

Procedure, began at the Northwest corner of D.L.C. No. 66 a  
bolt with 1 1/2" head found in roadway and ran a traverse south  
along the Central Point Jacksonville Highway to a 1 1/2" Pipe  
the N.E. Corner of D.L.C. No. 68, in the process tied a sandstone  
monument with cross buried 8 inches underground at a point on the  
D.L.C. Line 2671.71 feet south of the Northwest corner of D.L.C. no. 66  
A traverse was next run around the boundaries of the 40 acre  
ranch tying all corners available, and several Solar observations  
were taken for bearing.

This work was then co-ordinated for closures and checks to  
determine which points if any were acceptable, and the 5 acre  
tract was then staked as shown on the accompanying plat.

L.N.Dow.

