

G.H. JACKSON
LOCATED IN SEC. 20, T.34 S.
R.I.W. OCT. 1952

21 22
20 27

11/9/52

488

REGISTERED
OREGON
LAND SURVEYOR

C. Z. Boyden.

MARCH 10, 1944
C. Z. BOYDEN

1256.6

SOUTH

S47°06'W
321.29

N88°50'W
415.20

WEST 32.76

30°

H.W.V.

NORTH

5292.36

1466.83

CRATER LAKE

N

SCALE - 1" = 100'
• IRON PIN

653.24
EAST

30°

1323.09

20° 27
33 34

JACKSON
RCV'D 1952
COUNTY
ENGINEER-SURVEYOR

9881

Survey narrative to comply with Section 87.330 Oregon State Law, 1947

488

Survey No. _____

For: G. H. Jackson

Location: Section 28, Township 34 South Range 1 West Willamette Meridian


Purpose: To establish the boundaries of said property.

Traversed the East boundary of Section 28 from a corner set from the one remaining bearing tree for the Southeast corner to a 2" iron pipe set for the reestablished Northeast corner of said section. By astronomical observation this line was found to bear North and measured 5292.36 feet.

Since the $\frac{1}{4}$ Section corner has been destroyed set a point $\frac{1}{4}$ the distance North of the Southeast corner of said section, said point being the Southeast corner of Government Lot No. 2. Then set a point on said section line 2485.94 feet South of the Northeast corner of the Section and then ran West 30.0 feet to the West right of way line of the Crater Lake Highway, continued West 2.76 feet to a deed record point of angle, then ran North $88^{\circ} 50'$ West 415.2 feet, South $47^{\circ} 06'$ West 321.29 feet then South to a point 16.5 feet North of a line West from the above mentioned Lot corner. Then ran East 653.24 to the West right of way line of said Highway to close the tract. Tum Pins were set for all corners.

October 27, 1952

C. Z. Boyden

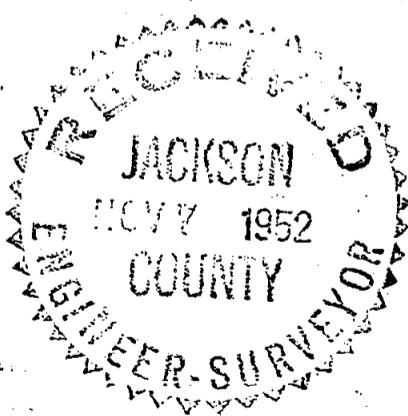

MARCH 10, 1944
C. Z. BOYDEN