

NORTH 735.80'

EAST 366.00'

264.00'

1 ACRE TRACT

N. 165.00'

S. 165.00'

264.00'

N. 132.50'

S. 132.50'

W. 264.00'

BOUNDARY LOCATION
 PROPERTY SITUATE IN
 N.W. 1/4 SECTION 14
 TWP. 39S. R.1E. W.M.
 JACKSON CO., OREGON
 J.H. CLABBY CIVIL ENGINEER
 MEDFORD, OREGON MAY 9, 52
 SCALE 1" = 100'

S. 56° 14' E.

NORTH LINE SISKIYOU BLVD.


I.P. FOUND

264.00'

FOUND

I.P.

I.P. FOUND

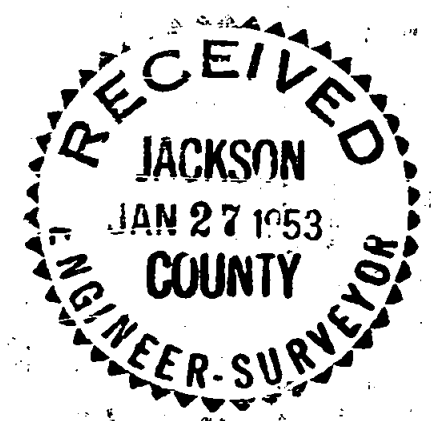

I.P. FOUND

Survey Narrative to Comply with Section 87-330, 1947 Oregon State Laws.

Survey for: Thomas Findlay

Location: Northwest Quarter Section 14, Township 39 South, Range 1 East, Willamette Meridian, Jackson County, Oregon.

Purpose: To locate and set corners on the north one acre tract of the land described in Volume 293, pages 126 and 127 of the Deed Records of Jackson County, Oregon.

Procedure: The property was described from a point on the north line of Siskiyou Blvd. 371.58 feet north of the Southwest corner of the Northwest Quarter of Section 14, Township 39 South, Range 1 East of the Willamette Meridian, Jackson County, Oregon, thence North 735.8 feet and East 366.00 feet to the true point of beginning. The point on north line of Siskiyou Blvd. could not be definitely located but a close approximation was determined from existing fences and other markings on the ground. This was used for verification of four pipe monuments set by a Registered Surveyor (R.S.No. 21) from said pipe monuments the true point of beginning was established, thence East 264.0 feet to the westerly line of Clay Street, thence South along said westerly line 165.00 feet, thence West 264.00 feet, thence North 165.00 feet to the point of beginning.

May 1952

J. H. Clabby

