


Survey No. 522

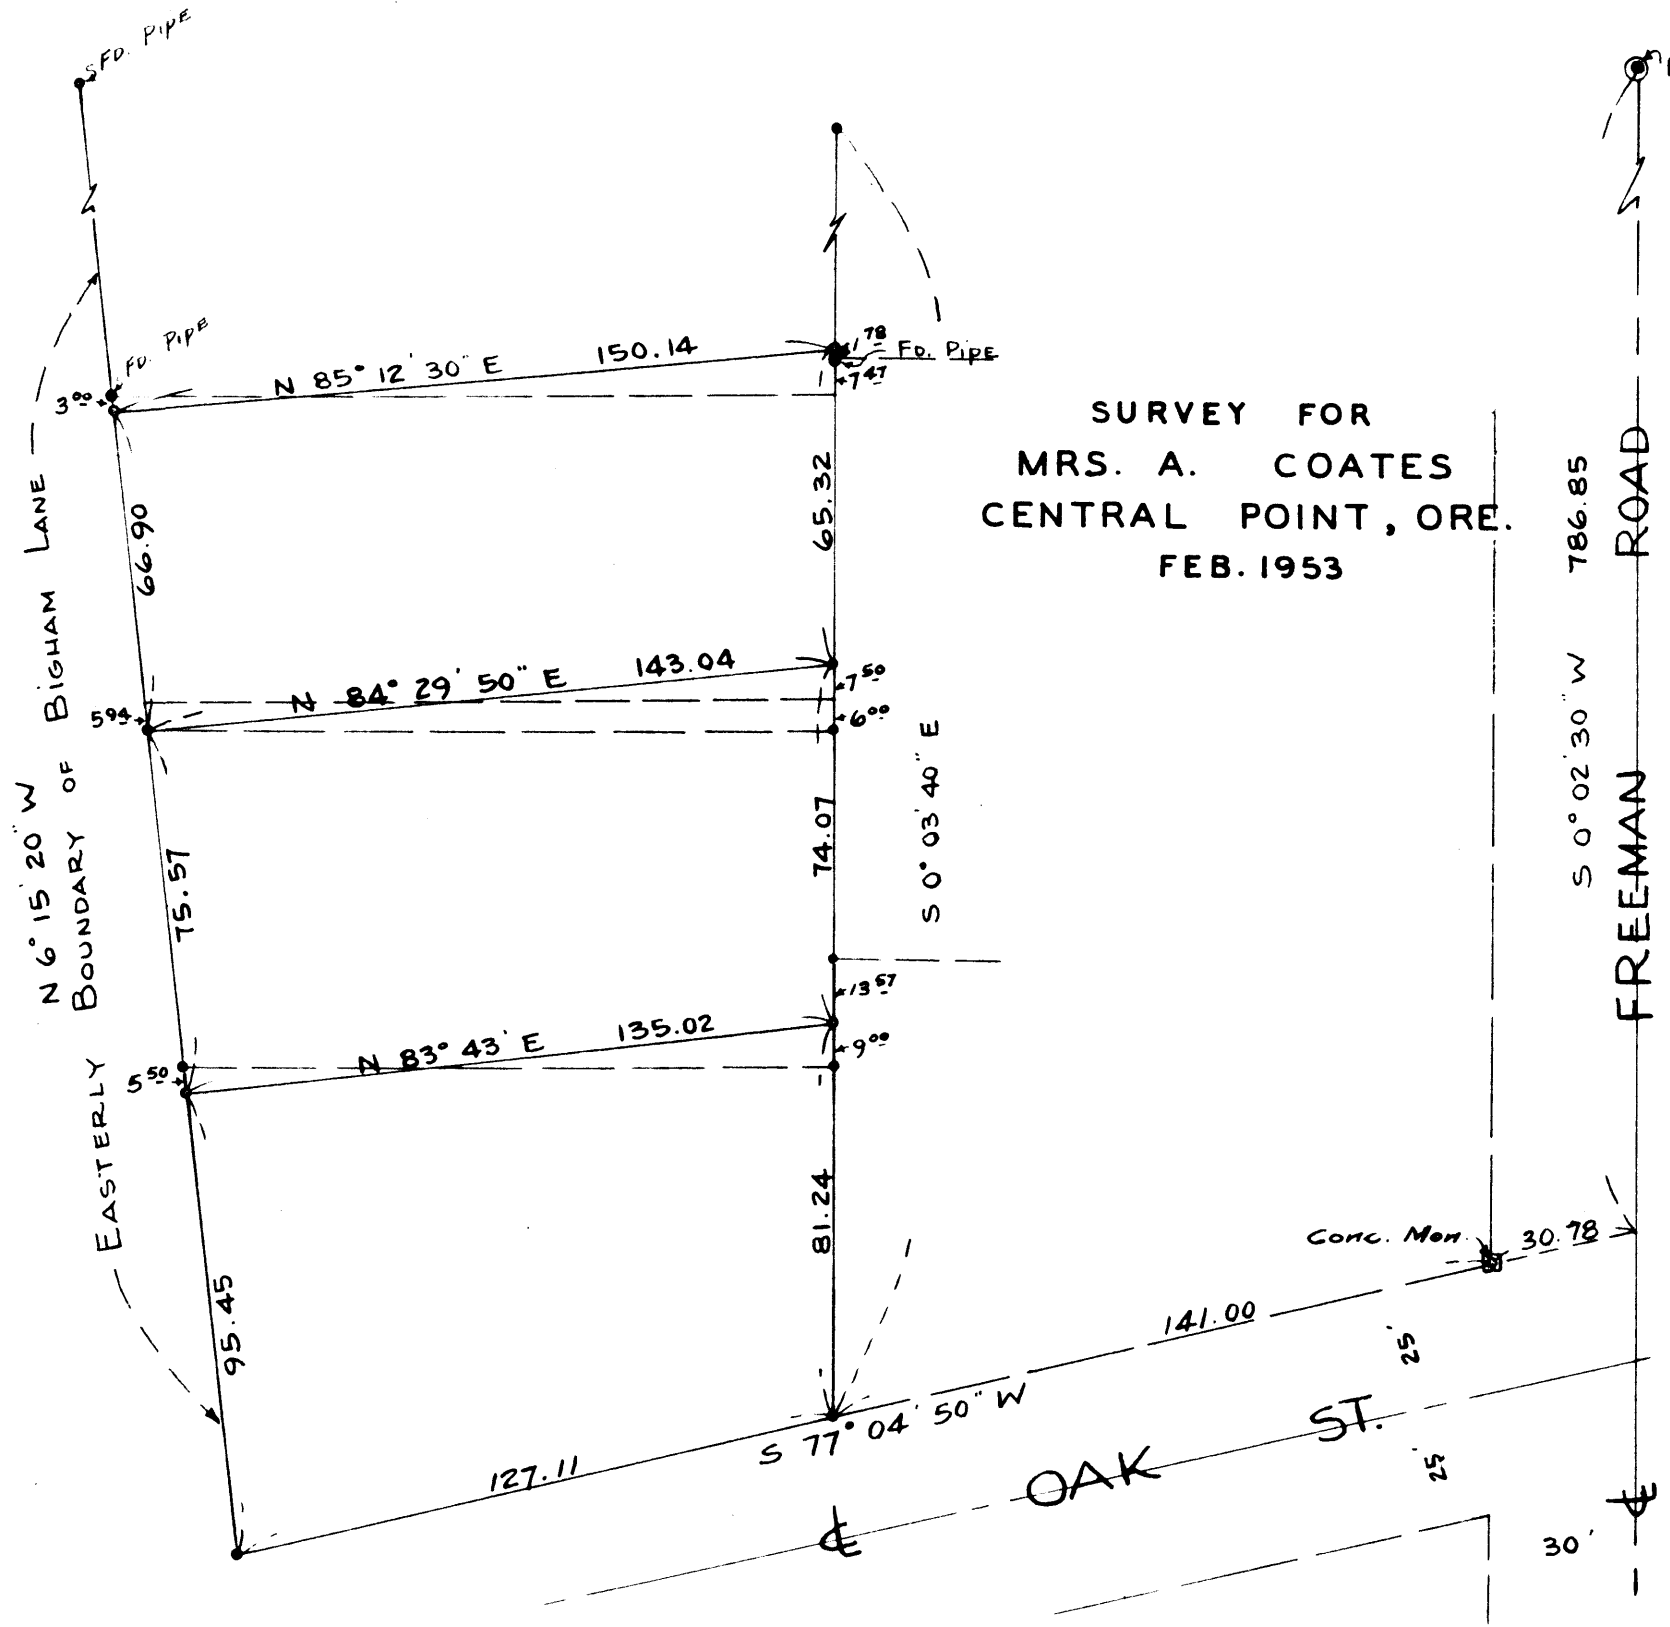

SURVEY FOR
MRS. A. COATES
CENTRAL POINT, ORE.
FEB. 1953

NW COR. DLC # 56
(STONE WITH 'X')

SCALE: 1" = 40'

- FOUND IRON PIN
- SET IRON PIPE

REGISTERED
OREGON
LAND SURVEYOR

C. Z. Boyden

MARCH 10, 1944
C. Z. BOYDEN
7

Sec. 2, T. 37S, R. 2W.

Survey No. 522

Survey For: MRS. A. COATES

Purpose: To re-describe and monument the McCullough and Coates property lying along the easterly boundary of Bigham Lane, in Central Point, Oregon.

Procedure: From monuments found and set on a previous survey and filed in the County Surveyor's Records as Survey No. 521, set iron pipes at the new property corners and prepared descriptions for the parties involved (McCullough, Coates and Bigham) to quit-claim to the new established property boundaries.

REGISTERED
OREGON
LAND SURVEYOR

C. Z. Boyden

MARCH 10, 1944
C. Z. BOYDEN
7

