


SURVEY FOR
BURTON GREEN
 LOT 4 BLOCK 3 SUNSET PARK
 SECS. 26 & 35 T37SR2W
 BY: C.Z. BOYDEN MAR. 1953

REGISTERED
OREGON
 LAND SURVEYOR

MARCH 10, 1944
 C. Z. BOYDEN
 7

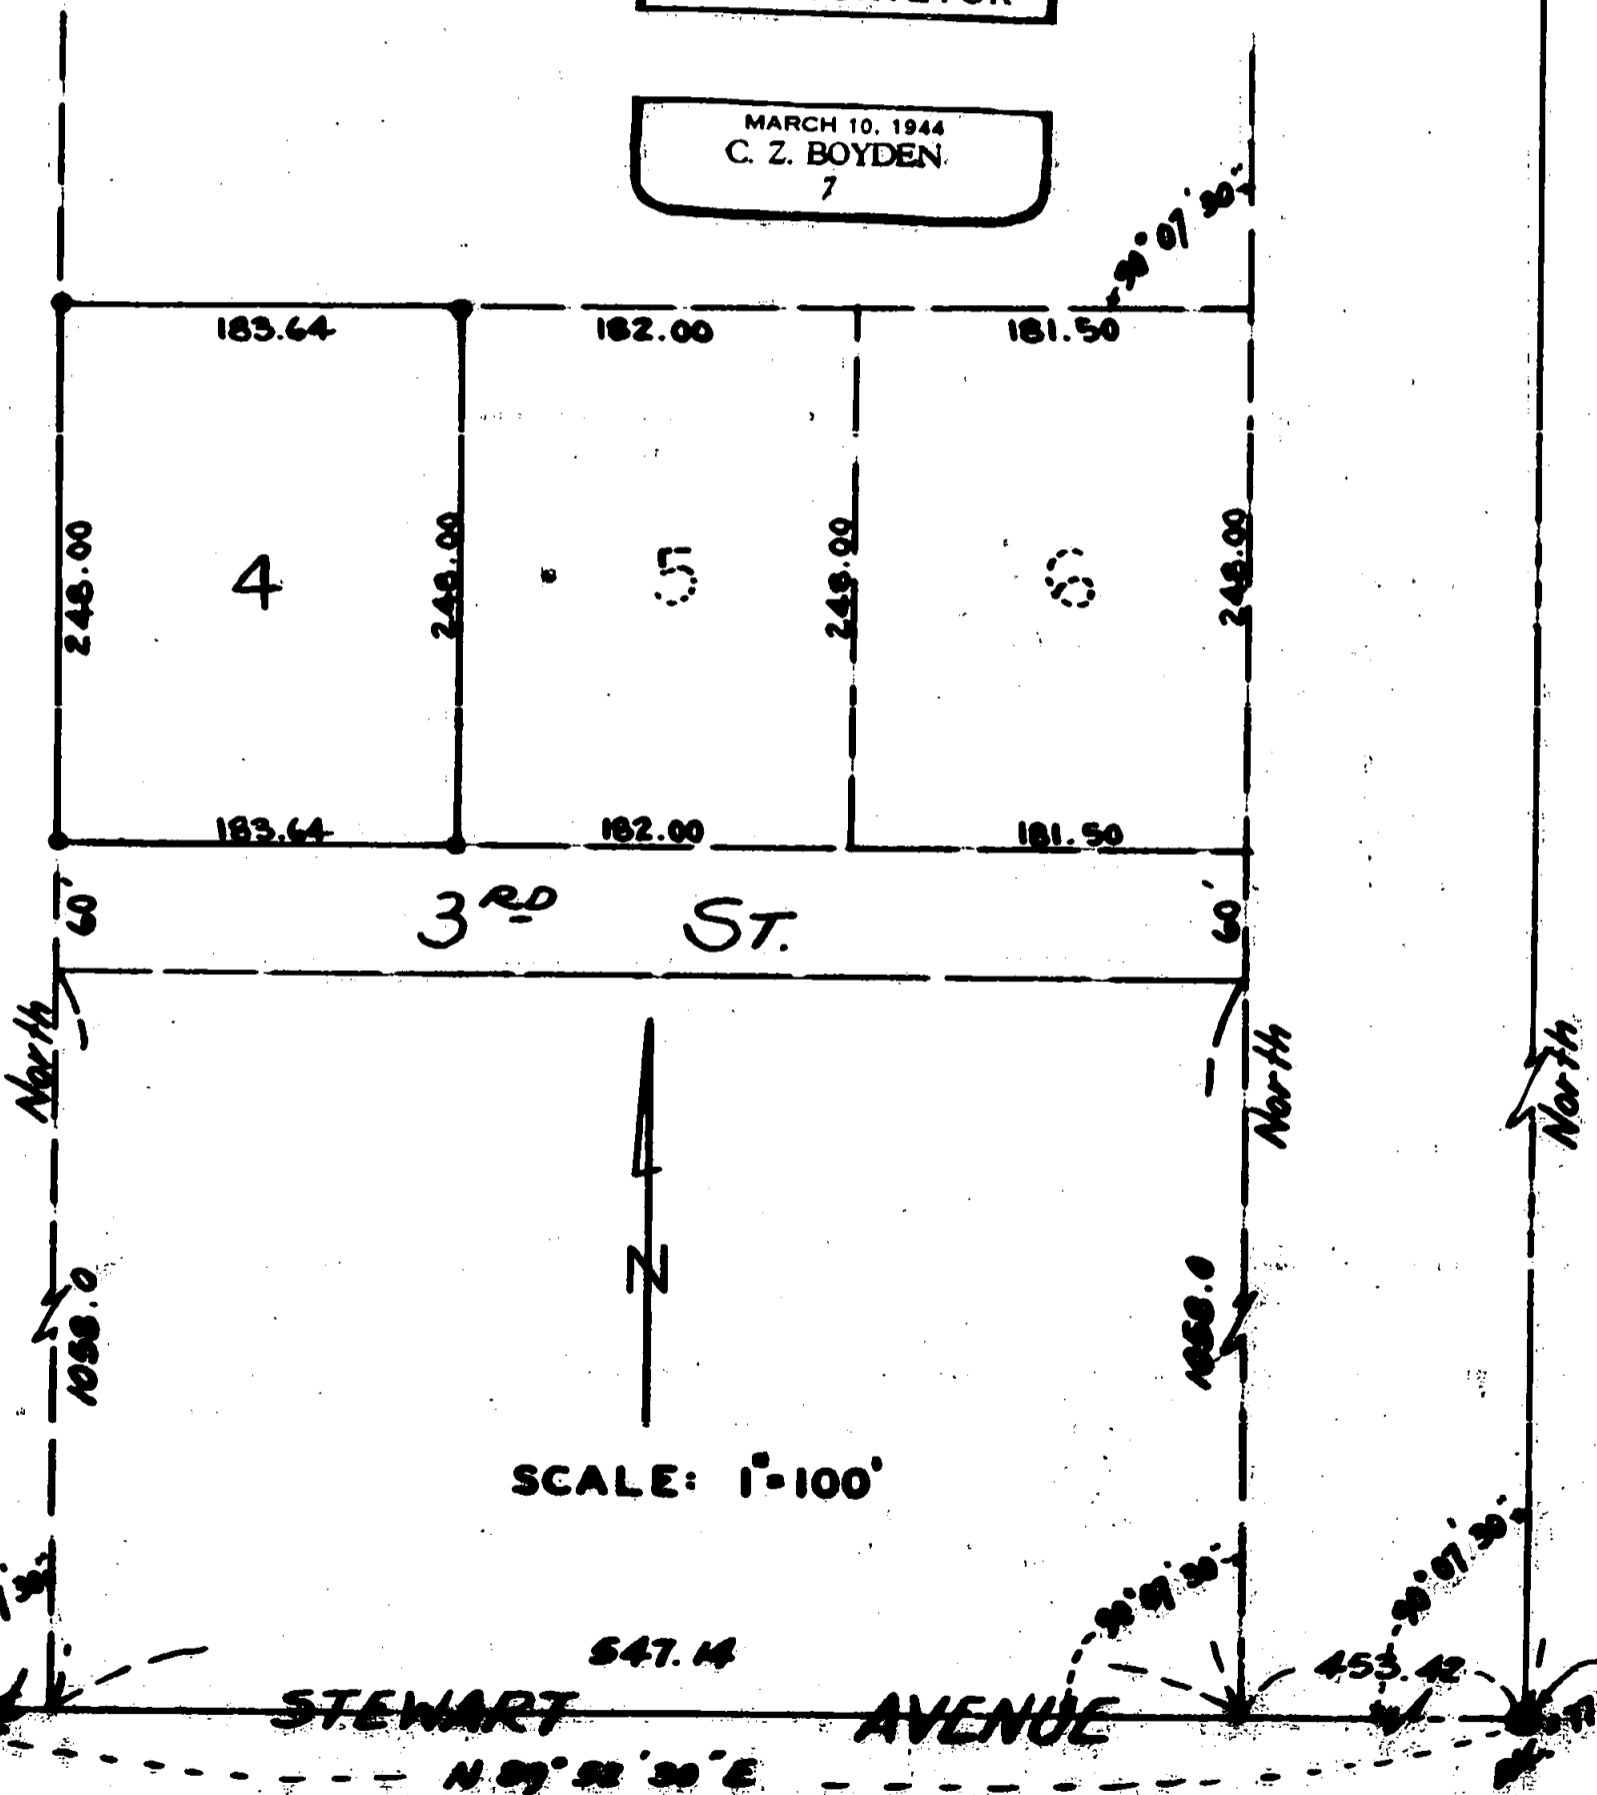

- RE-ESTBD. GOV'T. COR.
- SET IRON PIPE
- SET IRON PIN

Survey Narrative to Comply with Section 87-330 Oregon
State Law, 1947

Survey No. 525

For: BURTON GREEN

Purpose: To survey Lot No. 4 of Block No. 3 Sunset Park
Section 35 and 37 South, Range 2 West.

A comprehensive study of the Sunset Park plat and the title of said land prior to the subdivision indicates considerable confusion as to the location of the North boundary of said plat. Descriptions conveying said properties make reference to Lots of surveys of which we have no record since the plats were not recorded.

Also since the delineated plat and the boundary description of Sunset Park do not agree insofar as the North line is concerned the physical location of said line is left in doubt eliminating the possibility of a proportion. Since the South line and the East and West boundaries are definite both by deed description and platting, the location of Lots are established at a record location as controlled from the East line and South line of D.L.C. No. 77 as indicated on the plat.

March - 1953

Recording on file

REGISTERED
OREGON
LAND SURVEYOR

C. Z. Boyden

MARCH 10, 1944
C. Z. BOYDEN
7

