

542

REGISTERED
OREGON
LAND SURVEYOR

Leland P. Lovejoy

NOVEMBER 8, 1948
LELAND P. LOVEJOY
262



Boundary Location
property situated in
SEC. 17 & 20, T. 37 S., R. 2 W., W. M.
Jackson County Oregon

L. P. Lovejoy Medford, Ore.

March 16, 1952 - Scale 1" = 200'

Revised Dec. 30, 1952

Survey Narrative to Comply with Section 87-330

1947 Oregon State Laws

Survey for: Mrs. Nellie J. McCarty and
Mr. Leland Goff
Springbrook Road
Medford, Oregon


Purpose of Survey: To run out property boundaries.

Survey Location: Sections 17 and 20, Township 37 South,
Range 2 West, Willamette Meridian,
Jackson County, Oregon

Survey Procedure: Found monuments shown on map. Set 1"
iron pipe on boundary corners.

Leland P. Lovejoy, Registered Land Surveyor

Work completed December 31, 1952

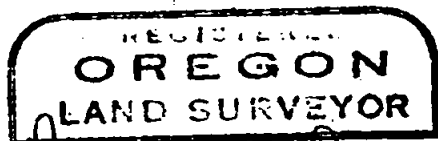

Leland P. Lovejoy

