


REGISTERED
OREGON
 LAND SURVEYOR
Leland P. Lovejoy
 NOVEMBER 18, 1949
LELAND P. LOVEJOY
 262

543

Boundary Survey of portions of Lot 2, Block 2
and Hockenjos Addition to Lot 1, Block 2 of
Cottage Addition to the City of Medford,
Jackson County, Oregon

L.P. Lovejoy Medford, Ore.
 Scale 1" = 100' May 30, 1953

- Monuments found or set (1/2" steel pins set unless noted)
- Monuments not set

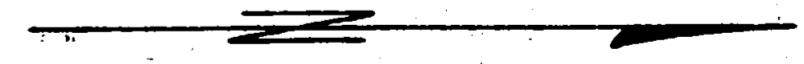

Survey No. 543

Survey Narrative to Comply with Section 87-330

1947 Oregon State Laws

Survey for: Medford Millworks
Medford Steel Co.
Blow Pipe Inc.
Tru-Mix Construction Co. (a Corporation)
Medford, Oregon

Purpose of Survey: To run out property boundaries.

Survey Location: Lot 2, Block 2, and Hockenyos Addition
to Lot 1, Block 2, of Cottage Addition
to City of Medford, Jackson County,
Oregon.

Survey Procedure: Monuments found or set as shown by
legend on map. Ran traverse around
entire Block 2 of Cottage Addition
and proportioned distances accordingly.

Leland P. Lovejoy, Registered Land Surveyor

Work completed June 9, 1953

