

Survey # 544

COOP SURVEY FOR
ELK LBR. CO., CALIFORNIA OREGON
POWER CO. & EUGENE BURRILL
SECS. 6 & 7, T.33 S., R.3 E., W.M.
C Z BOYDEN APR. 22, 1953

REGISTERED
OREGON
LAND SURVEYOR

MARCH 10, 1944
C. Z. BOYDEN
7

T.32 S.
T.33 S.

R.3 E.
R.2 E.
36.31
126 FOUND

REC. 32.04 CHS.
2113.3
50°22'50"E

GOV. WITNESS COR.
FOUND

NOTE: THIS CORNER
WAS SET ON A
SINGLE PROPORTION
BETWEEN GOV. REC.
AND MEASURED
DISTANCES AND ON
LINE BETWEEN THE
GOV. WITNESS COR.
TO THIS COR. AND THE
PROPORTIONED COR.
TO SECS. 16, 7 & 12

ROGUE
RIVER
CANYON



SCALE = 1" = 600'

REC. 4796 CHS.
2663.15
50°03'20"E

NOTE: THIS CORNER
WAS SET ON A SINGLE
PROPORTION
BETWEEN RECORD
AND MEASURED
DISTANCES AND ON
LINE BETWEEN THE
GOV. WITNESS CORNER
TO THE 1/4 CORNER TO
SECS. 1 & 6 AND THE
1/4 CORNER TO SECS.
12 & 7.

126
126.7
1932.23
REG. 49.10 CHS.
509°03'05"E
1327.99
6
7 FOUND
REC. 4000 CHS.
1337.10
N85°36'40"E
1337.10
6
7 FOUND

REC. 4000 CHS.
1337.10
50°03'20"E

126 FOUND

Survey Narrative to Comply with Section 87-330 Oregon
State Law (1947)


For: Elk Lumber Company, California Oregon Power Company
and Eugene Burrill.

Purpose: To establish the west and south lines of Section
6, Township 33 south Range 3 east.

Began at the re-established Township corner to
Townships 32 and 33 South, Ranges 2 and 3 East, and ran on
random line south to the witness corner to the $\frac{1}{4}$ corner to
Sections 1 and 6, where an original witness tree was found.
Then triangulated across the Rogue River Canyon and con-
tinued south to the $\frac{1}{4}$ corner to Sections 7 and 12, the
first Government corner which could be established from
evidence of original witness trees. Then computed the
location of the Section corner, $\frac{1}{4}$ corner and 1/16 corners
along this line by a single proportion between record and
measured distances. Then ran on random line east on the
south boundary of Section 6 to the $\frac{1}{4}$ corner and continued
to the southeast section corner of Section 6, which corners
were established from evidence of the original witness trees.
Then computed the location of the 1/16 corners by a single
proportion between record and measured distances. Iron
pipe monuments were set at all corners established or
re-established.

April 22, 1953

C. Z. Boyden

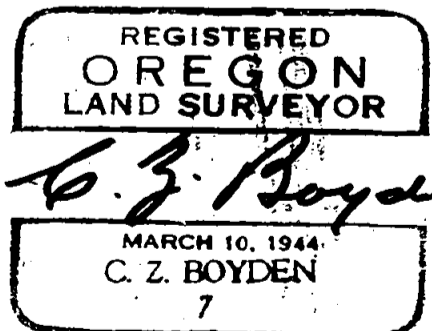

Keating on file