

T. 33 S., R. 4 W.,
Willamette Meridian, Oregon.

U. S. GOVERNMENT PRINTING OFFICE : 66-271

Corner Rehabilitation on the Josephine-Jackson
County Line in Mineral Survey
No. 923.

The cor. of secs. 25, 30, 31, and 36, on W. bdy. of
T. 33 S., R. 4 W., is determined at the record meas-
urements from the original NE. and SW. bearing trees;
all other record evidence of this cor. has been de-
stroyed by logging operations.

At the corner point, which falls beneath an uprooted
Douglas fir, 42 ins. diam.,

Set an iron pipe, 3 ft. long, 2 ins. diam., 28 ins. in
the ground, mkd. RS33; from which the extant original
bearing trees:

An incense cedar, 30 ins. diam., bears N.43°E., 51
lks. dist., mkd. T33S R4W S30 BT.

An incense cedar, 14 ins. diam., bears S.65½°W., 37
lks. dist., mkd. T33S R5W S36 BT.



And new bearing trees:

An incense cedar, 8 ins. diam., bears S.68½°E., 78.7
ft. dist., mkd. T33S R4W S31 RS33 BT.

A Douglas fir, 40 ins. diam., bears N.51½°W., 13.3
ft. dist., mkd. T33S R5W S25 RS33 BT.

Grants Pass, Oregon.
August 6, 1953.

Norman D. Price
NORMAN D. PRICE,
Mineral Surveyor.

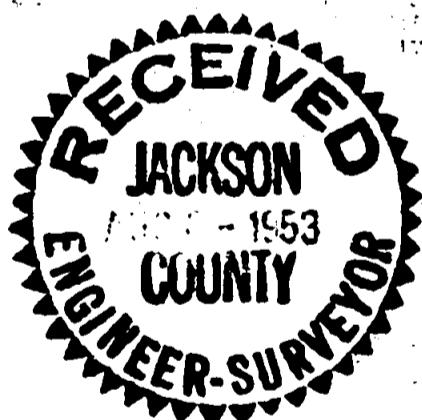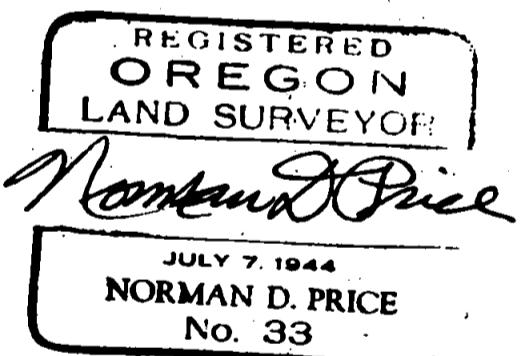

TOWNSHIP 34 SOUTH, RANGE 4 WEST, WILLAMETTE MER., OREGON.

Dependent Resurvey of Portion of Subdivisional Lines.

Chains.

The locus of the cor. of secs. 20, 21, 28, and 29 is determined at the record bearing and distance from each of the original bearing trees.

At the corner point,

Set an iron pipe, 3 ft. long, 2 ins. diam., 28 ins. in the ground, mkd. RS33; from which

A sawed yellow pine stump, 20 ins. diam., bears N.76°E., 57 lks. dist., with evidence of old blaze.

A yellow pine, 40 ins. diam., dead and down, bears S.50°E., 29 lks. dist., mkd. BT.

A black oak, 18 ins. diam., bears S.38°W., 34 lks. dist., with decayed old blaze.

The stump hole of a black oak bears N.20½°W., 54 lks. dist.

And new bearing trees:

A yellow pine, 7 ins. diam., bears N.17½°E., 115 lks. dist., mkd. T34S R4W S21 RS33 BT.

A black oak, 5 ins. diam., bears S.44½°E., 71 lks. dist., mkd. T34S R4W S28 RS33 BT.

A black oak, 20 ins. diam., bears N.31½°W., 81 lks. dist., mkd. T34S R4W S20 RS33 BT.

The geographic position of this cor. is lat. 42°35½'N., and long. 123°11½'W.

At this corner, June 12, 1953, I set off 42°35½'N. on the lat. arc, 23°11' N., on the decl. arc. at 7 a.m., app.t., on W. & L. E. Gurley solar transit No.461265 and determine a meridian with the solar transit. All azimuths of this survey are referred to the true meridian determined by this and subsequent observations.

Thence

S. 89° 40' W., on true line, bet. secs. 20 and 29.

40.21 Point for $\frac{1}{4}$ sec. cor. of secs. 20 and 29 determined at the record bearing and distance from the original SE. bearing tree.


At the corner point,

Set an iron pipe, 3 ft. long, 1½ ins. diam., 28 ins. in the ground, mkd. RS33; from which

A black oak, 26 ins. diam., bears S.5°E., 103 lks. dist., with the scribe marks $\frac{1}{4}$ S visible.

And a new bearing tree:

A black oak, 11 ins. diam., bears N.55½°E., 85 lks. dist., mkd. $\frac{1}{4}$ S20 RS33 BT.

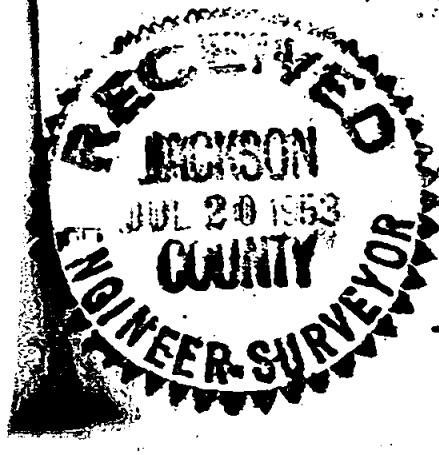

T. 34 S., R. 4 W.

Chains.

From the cor. of secs. 20, 21, 28, and 29

N. 0° 04' E., bet. secs. 20 and 21.

40.02 Point for $\frac{1}{4}$ sec. cor. of secs. 20 and 21, determined at the record distance from each original bearing tree.

At the corner point,

Set an iron pipe, 3 ft. long, $1\frac{1}{2}$ ins. diam., 28 ins. in the ground, mkd. RS33; from which

A maple, 9 ins. diam., dead and down, bears S.80°E., 23 lks. dist., mkd. BT.

A madrona stub, 12 ins. diam., bears S.82 $\frac{1}{2}$ °W., 10 lks. dist., on which only ax marks remain.

And new bearing trees:

An incense cedar, 10 ins. diam., bears N.2 $\frac{1}{2}$ °E., 14 lks. dist., mkd. $\frac{1}{4}$ S21 RS33 BT.An incense cedar, 6 ins. diam., bears S.67 $\frac{3}{4}$ °W., 51 lks. dist., mkd. $\frac{1}{4}$ S20 RS33 BT.

Thence

N. 0° 50' E., with new measurement.

40.21 Point for cor. of secs. 16, 17, 20, and 21, determined at the record distance from each original bearing tree.

At the corner point,

Set an iron pipe, 3 ft. long, 2 ins. diam., 28 ins. in the ground, mkd. RS33; from which

A madrona stool bears N.67°E., 120 lks. dist.

A madrona, 16 ins. diam., dead and down, bears S.15°E., 58 lks. dist., with partial scribe marks on decayed old blaze.

A madrona, 36 ins. diam., bears S.49°W., 61 lks. dist., with old blaze mutilated.

The stump hole of a sugar pine bears N.15°W., 22 lks. dist.

And new bearing trees:

A Douglas fir, 10 ins. diam., bears N.53°E., 45 lks. dist., mkd. T34S R4W S16 RS33 BT.


A Douglas fir, 34 ins. diam., bears S.45°E., 110 lks. dist., mkd. T34S R4W S21 RS33 BT.

An incense cedar, 46 ins. diam., bears S.38°W., 146 lks. dist., mkd. T34S R4W S20 RS33 BT.

A Douglas fir, 14 ins. diam., bears N.72 $\frac{1}{2}$ °W., 34 lks. dist., mkd. T34S R4W S17 RS33 BT.

N. 89° 46' W., bet. secs. 17 and 20.

JUL 20 1953

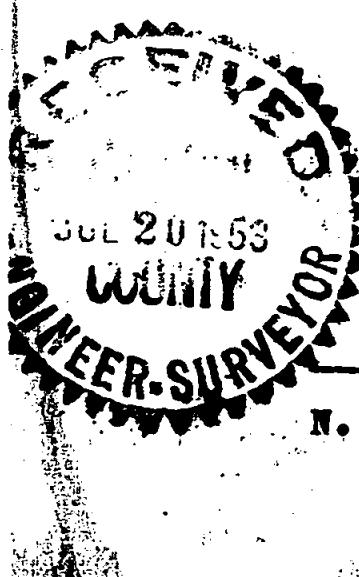

(No map accompanied this Narrative)

TOWNSHIP 33 SOUTH, RANGE 4 WEST, WILLAMETTE MER., OREGON

The locus of the cor. of secs. 25, 30, 31 and 36, on the W. bdy. of T. 33 S., R. 4 W., is determined at the record measurements from the original NE. and SW. bearing trees; all other record evidence of this cor. has been destroyed by logging operations.

At the corner point, which falls beneath an uprooted Douglas fir, 42 ins. diam.,

Set an iron pipe, 3 ft. long, 2 ins. diam., 28 ins. in the ground, mkd. RS33; from which the extant original bearing trees:

An incense cedar, 30 ins. diam., bears N.43°E., 34 ft. dist., mkd. T33S R4W S30 BT.

An incense cedar, 14 ins. diam., bears S.65½°W., 24.7 ft. dist., mkd. T33S R5W S36 BT.

And new bearing trees:

An incense cedar, 8 ins. diam., bears S.68½°E., 78.7 ft. dist., mkd. T33S R4W S31 RS33 BT.

A Douglas fir, 40 ins. diam., bears N.51½°W., 13.3 ft. dist., mkd. T33S R5W S25 RS33 BT.

The foregoing described corner was rehabilitated in connection with Mineral Survey No.923, Oregon.

Grants Pass, Oregon.
July 18, 1953.

Norman D. Price
Norman D. Price,
Mineral Surveyor.

