
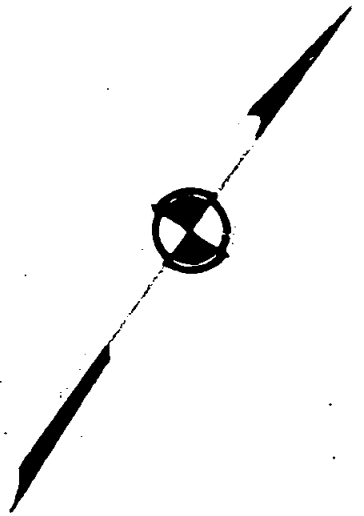


#561

For Narrative, see Volume 2, Page 75

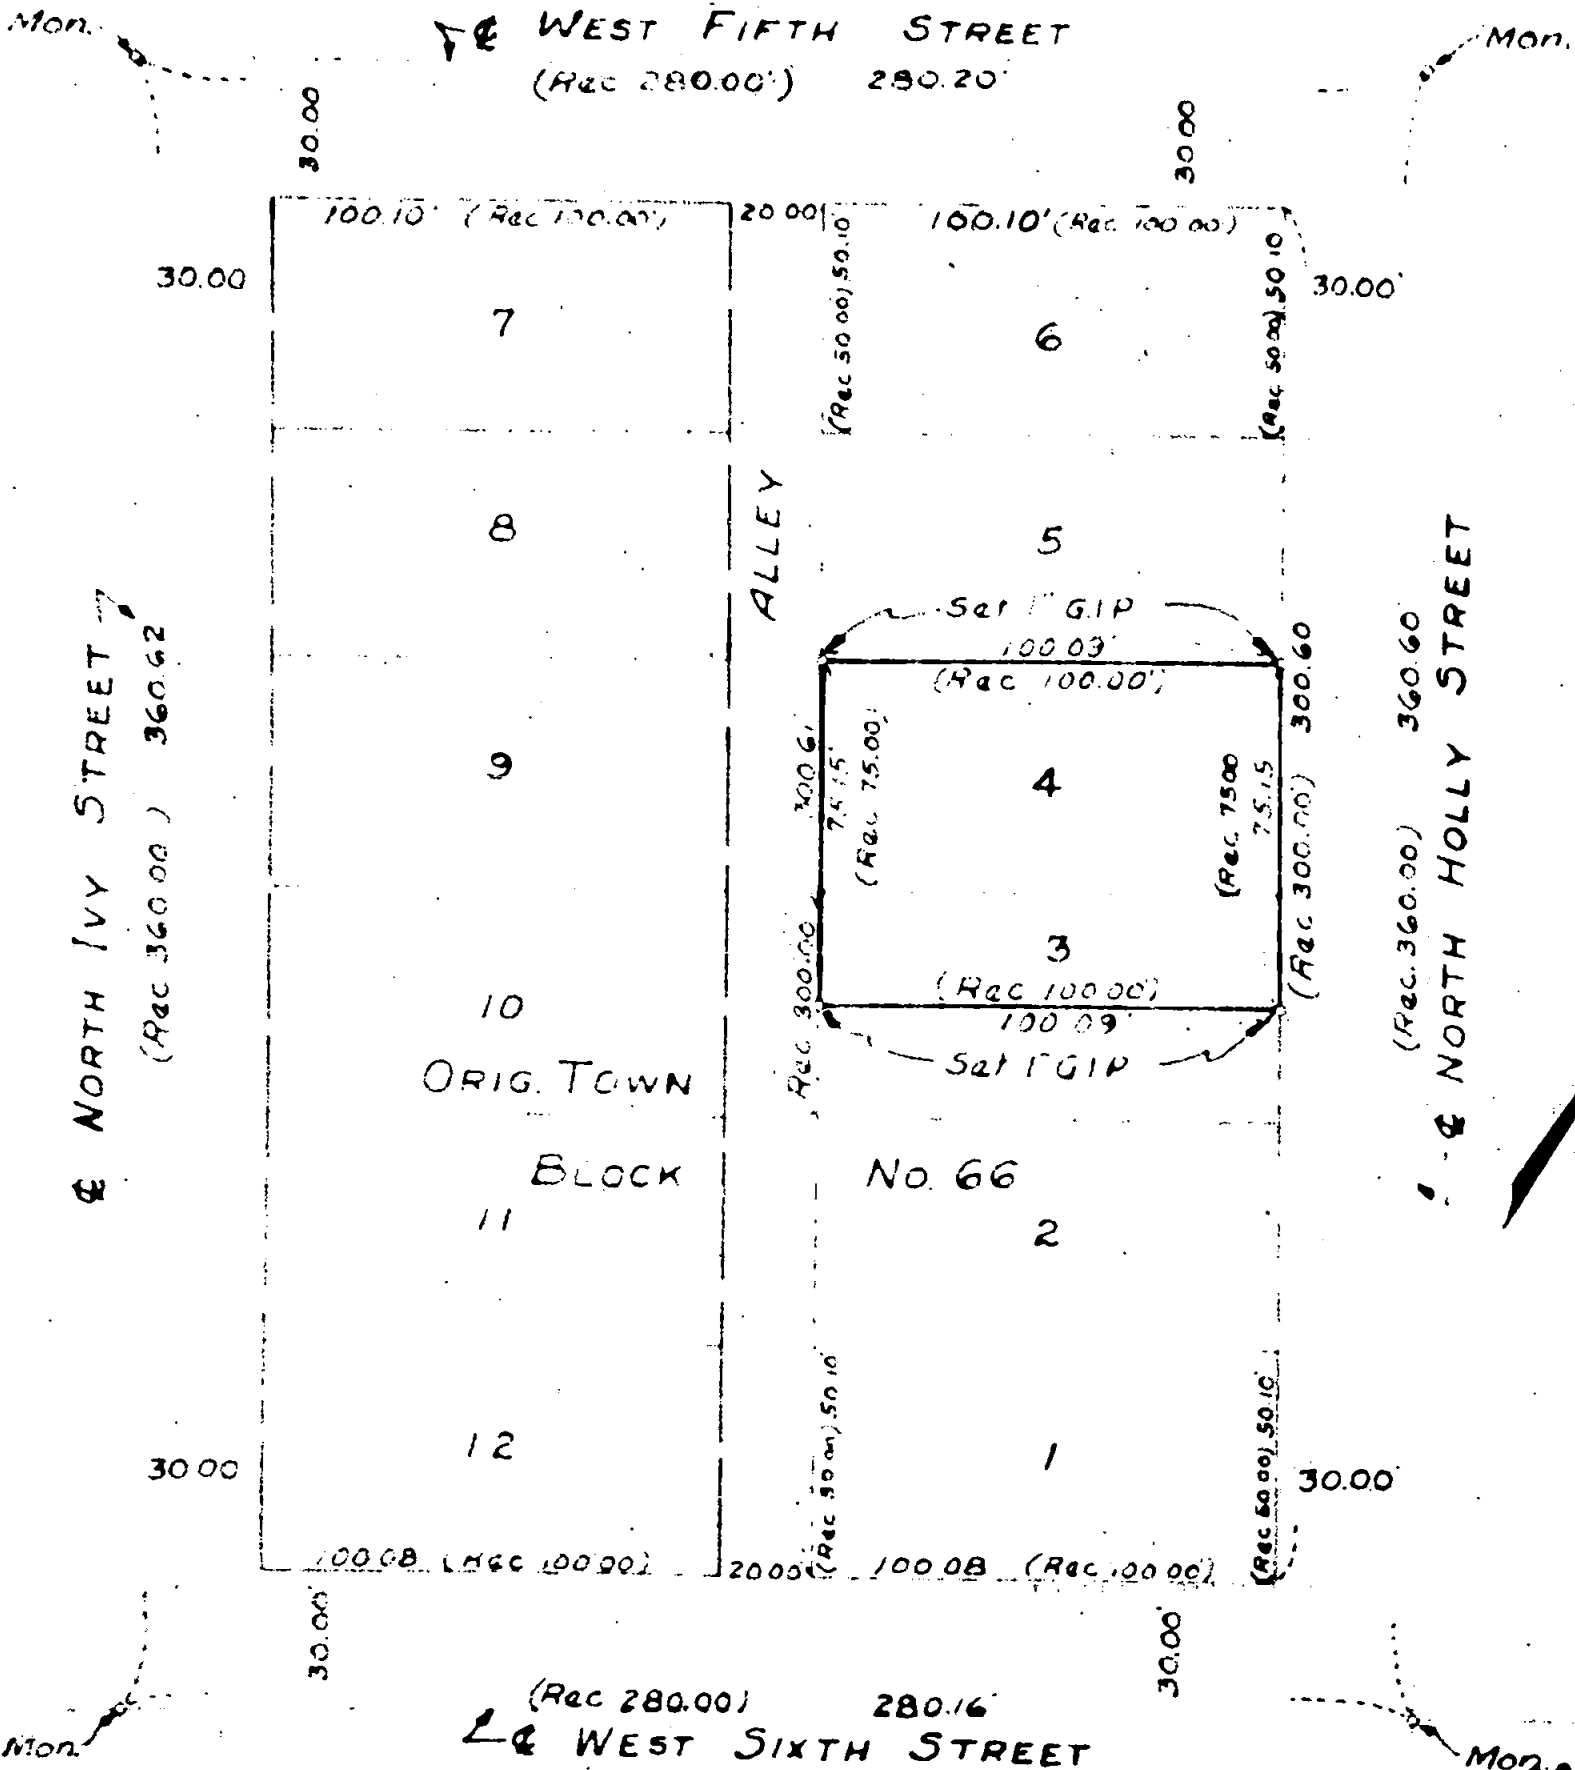

OREGON  
 LAND SURVEYOR  
*Leland P. Lovejoy*  
 NOVEMBER 1 1953  
 LELAND P. LOVEJOY  
 262

**RECEIVED**  
 JACKSON  
 COUNTY  
 ENGINEER-SURVEYOR  
 OCT 1 1953

SURVEY FOR ANTHONY J. BOITANO  
 NORTH 25.00' LOT 3 AND ALL LOT  
 4, BLOCK 66, ORIGINAL TOWN  
 MEDFORD, OREGON  
 SCALE: 1"=50'  
 3-18-53

Survey Narrative to Comply with Section 87-330

1947 Oregon State Laws

Survey For: Mr. Anthony J. Boitano  
Medford, Oregon

Purpose of Survey: To run out property boundaries

Survey Location: Portion Lot 3 and all Lot 4, Block 66,  
Original Town, Medford, Oregon.

Survey Procedure: Found monuments shown and set 1 inch  
G. I. pipe as indicated on map.

Leland P. Lovejoy, Registered Land Surveyor

Work completed June 2, 1953

