


DR 338-236
Fixes this
36 intersectn.
Cor.
(B.T.(Found))

DR 338-236
Fixes this W.O.
tree as definite
corner of Pt.
P.O.B
DR 394-184

Hixsons
House

Jackson Co. Road
Sta. 44+50.17

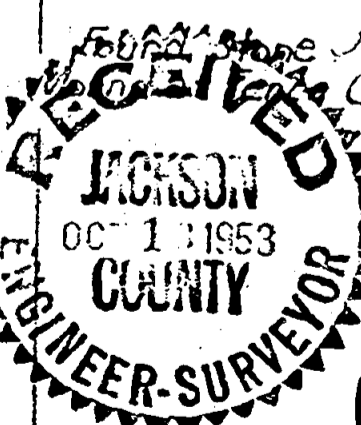

REGISTERED
OREGON
LAND SURVEYOR
Leland P. Lovejoy
NOVEMBER 18, 1949
LELAND P. LOVEJOY
262

Boundary Location
Property Situate in
D.L.C. 39, T.36S, R.3W, WM.
D.L.C. 37, T.37S, R.3W, WM.
Jackson County Oregon
L.P. Lovejoy L.S. Medford Ore
Scale 1" = 400' 2-5-53

Survey Narrative to Comply with Section 87-330

1947 Oregon State Laws

Survey For: Mr. Ralph Hixson
Gold Hill, Oregon

Purpose of Survey: To run out property boundaries.

Survey Location: D.L.C. 39 and D.L.C. 37, Townships 36 and
37 South, Range 3 West, Willamette
Meridian, Jackson County, Oregon.

Survey Procedure: Ran closed traverse and tied in and set
monuments and corners shown on map. An
old-time resident who had resided on this
property for a number of years made the
statement that the rock buried under the
stone mound at fence corner was the
Southwest corner of D.L.C. 37, as shown
on map, and replaced original Black Oak
corner tree which had died out. Extensive
digging in this immediate area did not
disclose any evidence of remains of this
corner tree. The record distances to this
corner check reasonably close to the
position of this fence corner.

Leland P. Lovejoy, Registered Land Surveyor

Work completed July 12, 1953

