



642

E. 12. Th Str

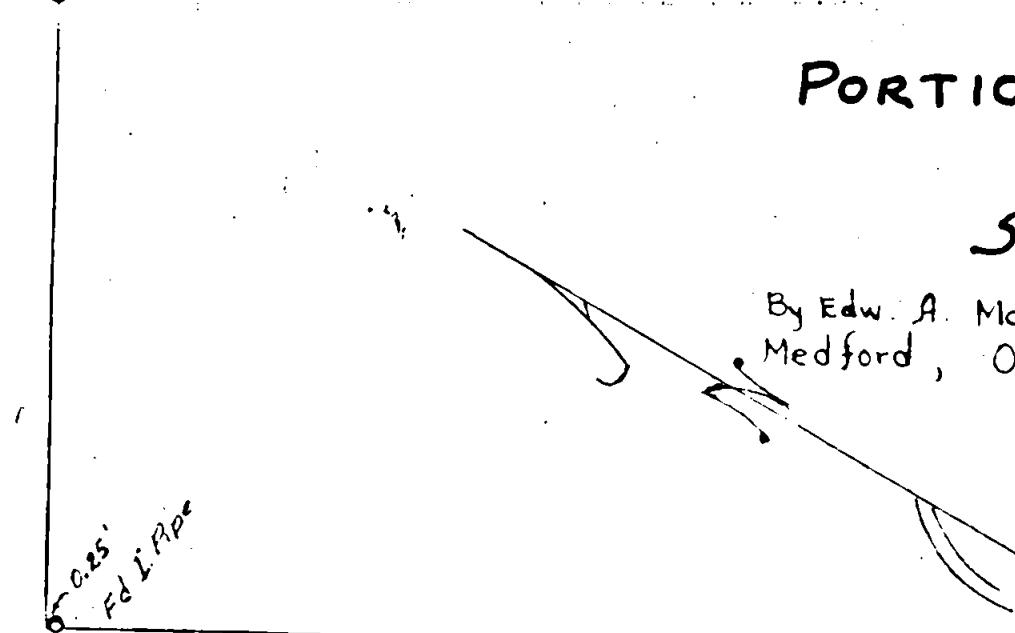


FRANQUETTE Ave


PORTIONS OF LOT 142

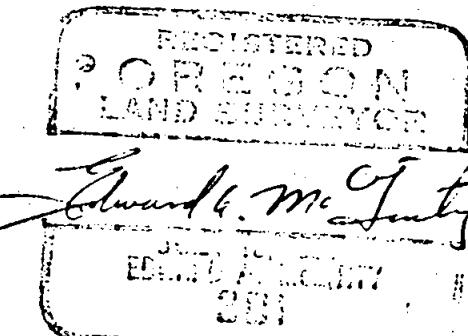As
ShownBy Edw. A. McGinty
Medford, OregonScale 1"=100
Sept 6, 1954

SOUTH SEA . Add.

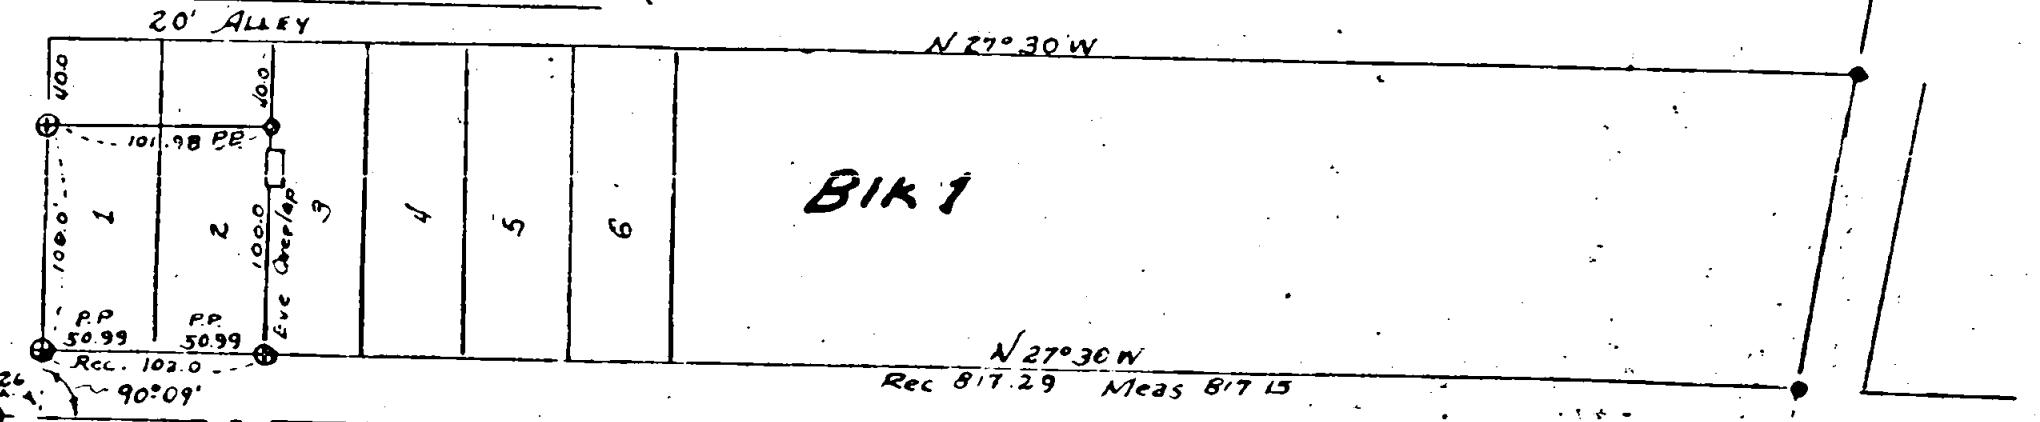

- Monuments Fd
- ⊕ Cross set
- 3/4" Pipe Set
- I. Pin Fd

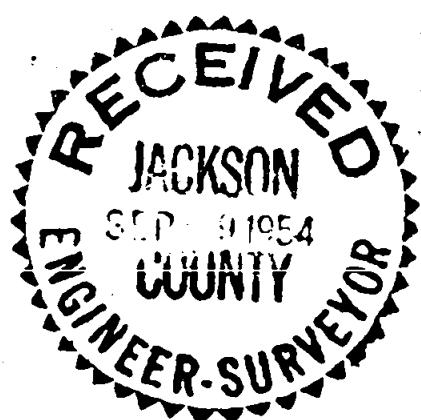

84-47

Survey No. 642

Survey Narrative to comply with Oregon State Laws.


Survey for: S.S. Humphries

By: Edward A. McGinty

BASIS OF BEARINGS: from surveys of records which comply with O.S.L.

PRECEDENCE OF SURVEY: Found monuments as shown set by previous surveys of record, found also the most westerly line slightly shorter than record and proportion lot line to records.

Sept. 9, 1954

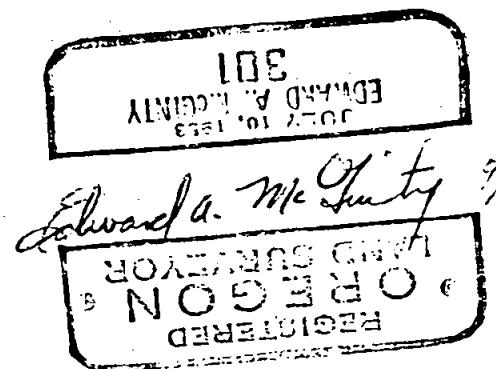

Edward A. McGinty 9/9/54

