


5294.46
2647.23

BOUNDARY LOCATION
Property Situate in
SEC. 28, T. 36 S., R. 1 W., W. M.
JACKSON COUNTY, OREGON
J. H. CLABBY Civil Engineer
Medford, Oregon March 1954
SCALE: 1" = 300'

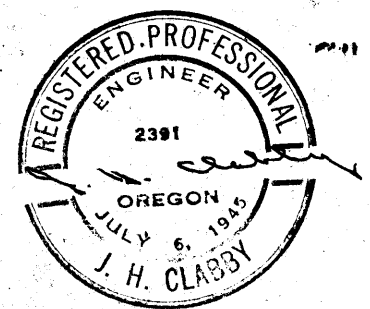

644

Survey Narrative to Comply with Section 87-330, 1947 Oregon State Laws.

Survey for: Claude Hoover

Location: Section 28, Township 36 South, Range 1 West Willamette Meridian, Jackson County, Oregon.

Purpose of Survey:

To locate and describe a parcel of land as indicated by owner.

Procedure: Found all four section corners. From southwest corner of Section 28, ran South $89^{\circ} 54' 30''$ East 30.00 feet to the east line of Sticky Lane for the true point of beginning, thence North $0^{\circ} 02' 30''$ West along said east line 902.68 feet, thence South $89^{\circ} 48'$ East 570.00 feet, thence North $0^{\circ} 12'$ East 60.00 feet, thence South $89^{\circ} 48'$ East 2400.00 feet, thence South $0^{\circ} 12'$ West 60.00 feet, South $89^{\circ} 48'$ East 2265.00 feet to the west line of Foothill Road, thence South $0^{\circ} 00' 30''$ East along said west line 892.66 feet, thence North $89^{\circ} 54' 30''$ West 5234.46 feet to the point of beginning.

J. H. Clabby

March 1954

