


650

11A

N.W. Cor. D.L.C. 58
(Record)

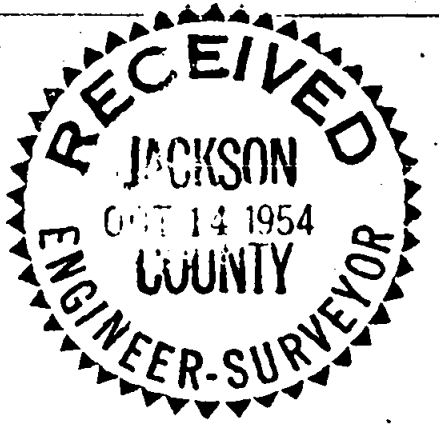

30' 30'

50.0'

—&— OLD PACIFIC HIGHWAY —&—

833.50'

610'

—&— PITT VIEW AVENUE —&—

787.10'

416.70'

304.40'

LOT 20

125.90'

0.723 AC ±

250.00'

125.90'

90°09'

476.70'

250.00'

S.E. Cor. LOT 20

89°51'

N.E. Cor. Lot 19

Found Iron Pipe

650

SET 1/2" steel pins

SCALE: 1" = 100'

BOUNDARY LOCATION
Property Situate in Lot 20
AMENDED PLAT of LOTS 3 to 10 incl.
PITT VIEW SUBDIVISION
JACKSON COUNTY, OREGON

J.H. CLABBY, C.E. MEDFORD, ORE.
JULY 1954



Survey Narrative to Comply with Section 87-330, 1947 Oregon State Laws.

Survey for: J. W. Langston

Location: Pittview Sub.- Amended Plat

Purpose of Survey:

To locate and describe a parcel of land as designated by owner.

Procedure: Found three iron pipe on North line and northeast corner of Lot No. 19 on Pittview Avenue. Ran northerly along the east line of Lot 20, 250.00 feet, thence westerly 125.90 feet, thence southerly 250.00 feet to the northerly line of Pittview Avenue, thence easterly along said northerly line 125.90 feet to the point of beginning.

J. H. Clabby

July 1954

