


653

BOUNDARY LOCATION
 Property Situate in
 SEC. 25, T. 36 S., R. 2 W., W. M.
 JACKSON COUNTY, OREGON
 J. H. CLABBY Civil Engineer
 Medford, Oregon January 1954

SCALE: 1" = 200'

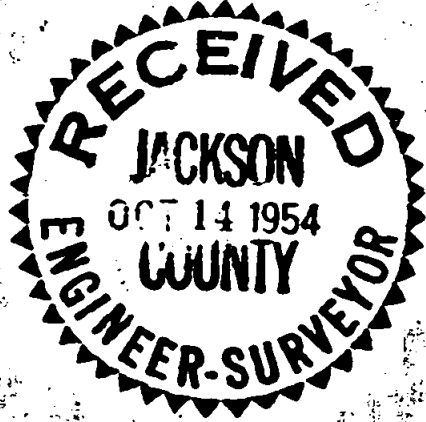

Survey Narrative to Comply with Section 27-330, 1947 Oregon State Laws.

Survey for: Henry W. Rohrbach
 Section 25, Township 36 South, Range 2 West, Willamette Meridian,
 Jackson County, Oregon

Purpose of Survey:

To locate and stake a parcel of land described as follows: "All but the South 30' of the West 158' of the east 144' of the S $\frac{1}{2}$ of the S $\frac{1}{2}$ of the N.E. 1/4 of the S.W. 1/4 of Section 25, Township 36 South, R. 2 W.W.M.

Procedure: Found $\frac{1}{2}$ " pipe set for center of Section 25.

Found C.S. 1/16 Section corner Sec. 25 at intersection of Table Rock Road and Gibbon Road.

Chained distance between above mentioned corners 1326.00 feet.

Located S.W. 1/16 corner Section 25, from reference points. Chained to C.S. 1/16 corner. Distance 1325.40 feet. Established center line of Gibbon Road and set points at 686 feet and 844 feet west from C. S. 1/16 corner. From said points turned North 0° 18' West and set corners at 30' and 301.50 feet on each line.

A fence overlaps the west line by 3.4 feet.

J. H. Clabby

January 1954

