

Survey Narrative to Comply with Section 87-330

State of Oregon Law (1947)

Survey for: The Pacific Telephone and Telegraph Company
509 S. W. Oak Street
Portland 4, Oregon


Purpose of Survey: To run out property boundaries

Survey Location: Section 8, Township 33 South, Range 4
West, Willamette Meridian, Jackson and
Douglas Counties, Oregon.

Survey Procedure: Section and Quarter corners found as shown
on map. Set 3/4" galvanized iron pipe at
property corners as indicated.

Leland P. Lovejoy
Registered Land Surveyor

Work completed November 15, 1954

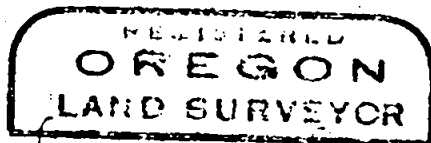

Leland P. Lovejoy

