

BOUNDARY SURVEY
 SITUATED IN
ALAN J. LOWREY PROPERTY
 Sec. 29 & 32, T. 35S., R. 1W., W.M.
 JACKSON COUNTY, OREGON
 L.P. LOVEJOY L.S. MEDFORD, ORE.
 SCALE: 1"=400' FEB. 22, 1955
 BEARINGS DETERMINED BY SOLAR OBSERVATION

Govt Lot 1
0-1" G.I. PIPE SET IN CONCRETE



(REC. NORTH 2640.00')

(REC. NORTH 2640.00')

Survey Narrative to Comply with Section 87-330

State of Oregon Law (1947)

Survey for: Alan J. Lowrey, Vice President
Union Oil Company
San Francisco, California


Purpose of Survey: To run out property boundaries

Survey Location: Sections 29 and 32, Township 35 South,
Range 1 West, Willamette Meridian,
Jackson County, Oregon

Survey Procedure: Found section, quarter section, and
one-sixteenth corners as shown on map.
Ran closed traverse. Subdivided
Section 29 on basis existing corners
found and records. Set 1" galvanized
iron pipes in concrete as indicated.

Leland P. Lovejoy
Registered Land Surveyor

February 28, 1955

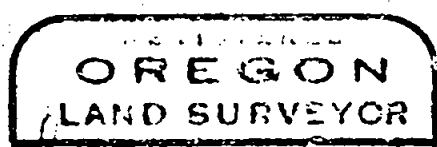

Leland P. Lovejoy

