

REGISTERED
OREGON
 LAND SURVEYOR

Leland P. Lovejoy

NOVEMBER 18, 1944
LELAND P. LOVEJOY
 262

Note -
 Bearing North this survey equals
 1 N 0°01'45" E by solar observation
 2 North by Lakewood Subd survey
 3 N 0°00'40" W by Rogue Valley Hts Subd survey

Legend

- Survey monument found
- Iron pipe found
- Iron pipe set

BOUNDARY LOCATION
 PROPERTY SITUATE IN
DLC 40 - SECS 18 & 19
T 37 S RIW WM
JACKSON COUNTY ORE
 L P Lovejoy Land Surveyor Medford Oregon
 SCALE 1"=200' 10 NOV 1954

Survey Narrative to Comply with Section 87-330

State of Oregon Law (1947)


Survey for: Ralph V. Cook
 Hillcrest-Phoenix Road
 Medford, Oregon

Purpose of Survey: To run out property boundaries

Survey Location: D.L.C. 40, Sections 18 and 19,
 Township 37 South, Range 1 West,
 Willamette Meridian, Jackson
 County, Oregon.

Survey Procedure: Found survey monuments, iron pipes,
 and set 1" galvanized iron pipes as
 indicated by legend on map. ran
 closed traverse.

Leland P. Lovejoy
 Registered Land Surveyor
 February 28, 1955

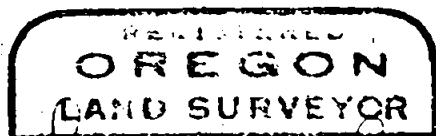

Leland P. Lovejoy

