


LAUREL ST. 7 650
CITY MON. FOUND

NOTE:
BEARINGS DETERMINED BY SOLAR OBSERVATION

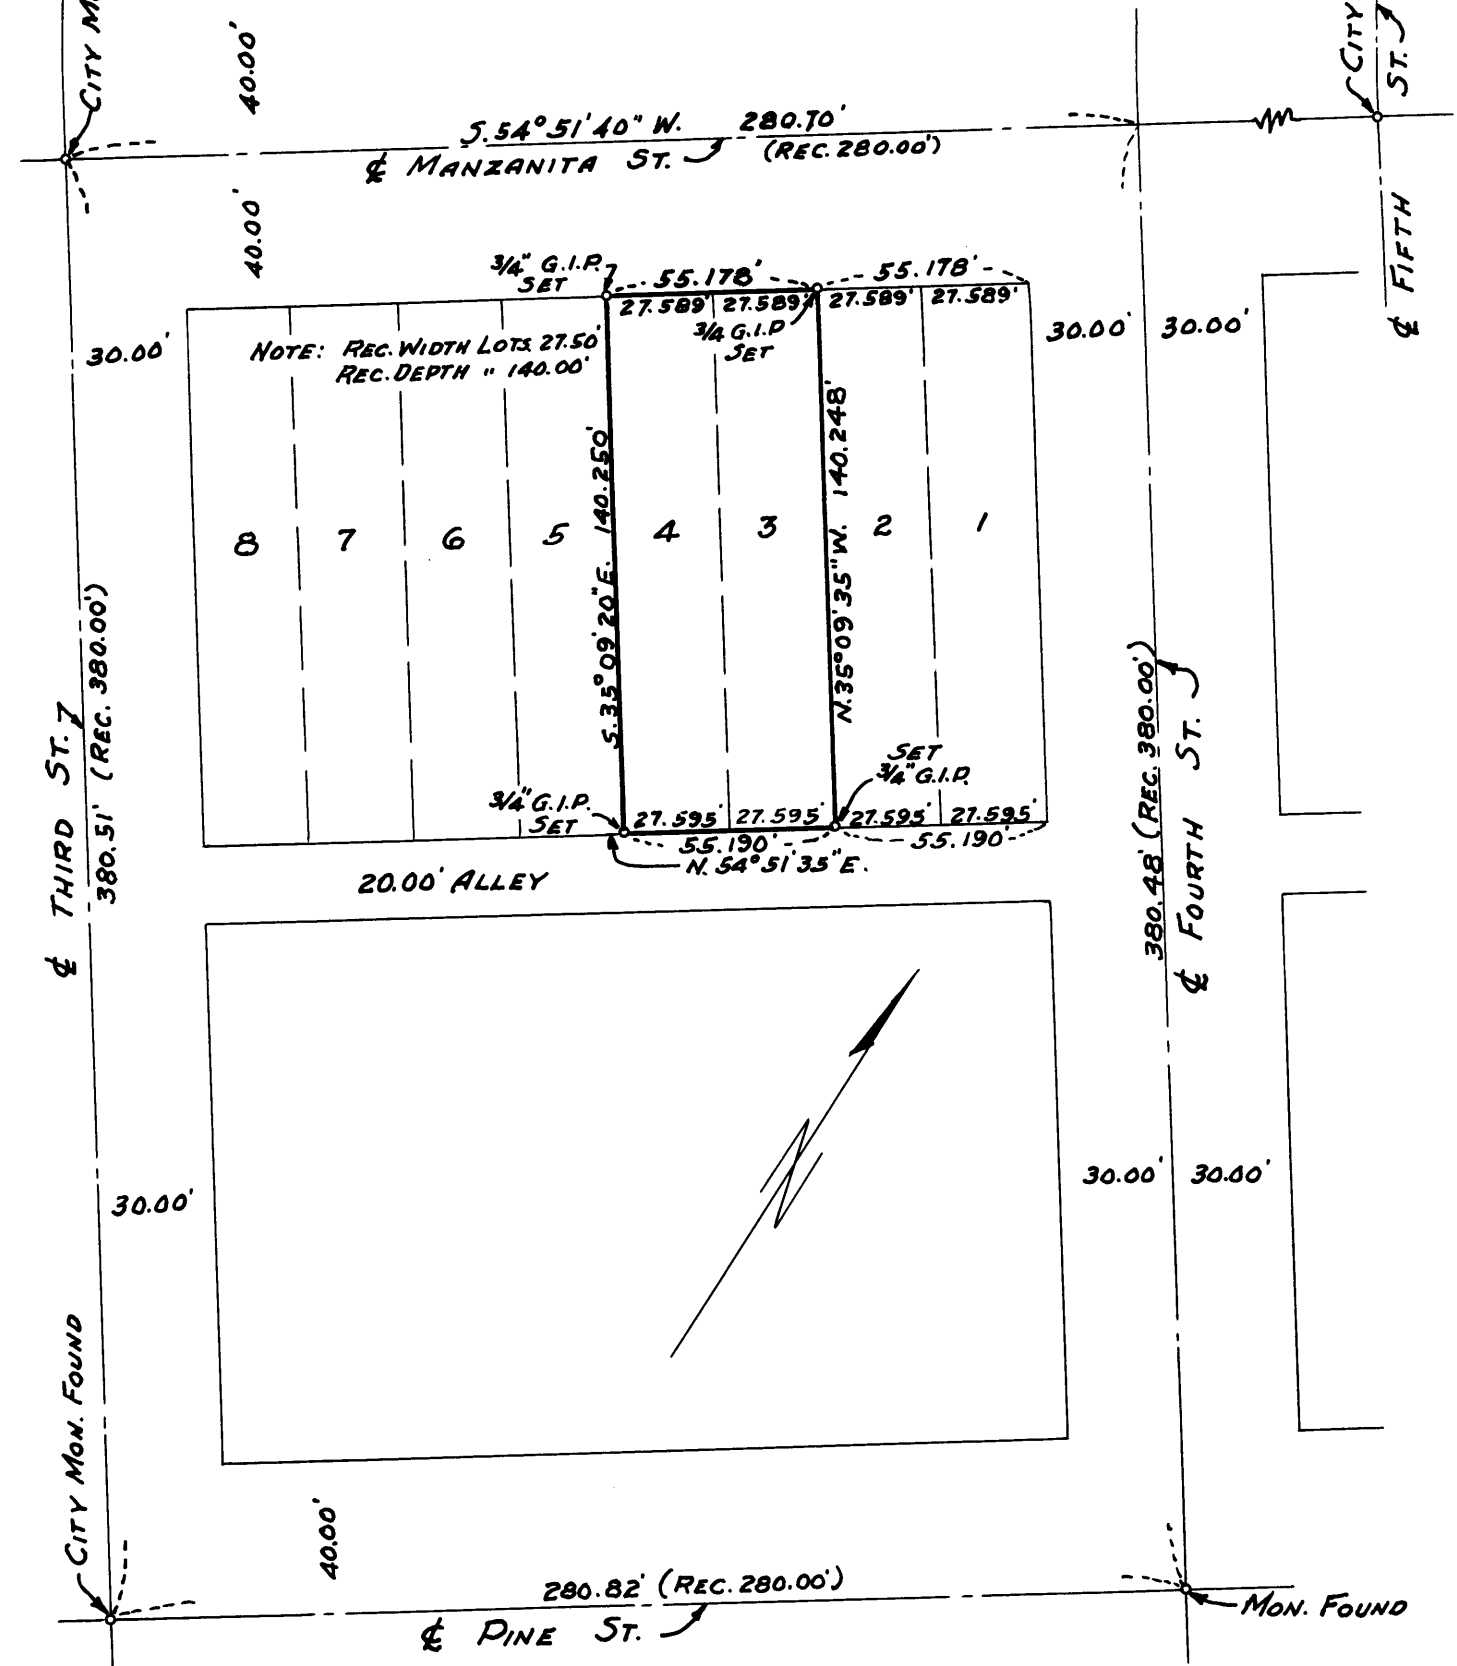

THIRD ST. 7
380.51' (REC. 380.00')

FOURTH ST. 7
380.48' (REC. 380.00')

CITY MON. FOUND

MON. FOUND

OREGON
 LAND SURVEYOR
 L.P. LOVEJOY
 1949
 282

PROPERTY SURVEY FOR
 THE PACIFIC TELEPHONE AND TELEGRAPH CO.
 LOTS 3 AND 4, BLOCK 3, ORIGINAL TOWN OF
 CENTRAL POINT, JACKSON COUNTY, OREGON
 L.P. LOVEJOY L.S. MEDFORD, ORE.
 SCALE: - 1" = 50'
 MARCH 23, 1954

Survey Narrative to Comply with Section 87-330State of Oregon Law (1947)

Survey for: The Pacific Telephone and Telegraph Company
507 S. W. Oak Street
Portland 4, Oregon

Purpose of Survey: To run out property boundaries.

Survey Location: Lots 3 and 4, Block 3, Original Town
of Central Point, Jackson County, Oregon.

Survey Procedure: Found monuments as indicated on map.
Ran traverse around Block 3. Proportioned
excess footage. Set 3/4" galvanized iron
pipe at property corners.

Leland P. Lovejoy
Registered Land Surveyor

Work completed July 3, 1954

