

NOTE:
BEARINGS DETERMINED BY SOLAR OBSERVATION

SURVEY FOR

THE PACIFIC TELEPHONE & TELEGRAPH CO.


SITUATE IN

SEC'S 33 & 34, T.40S, R.2E, W.M.

JACKSON COUNTY, OREGON

L.P. LOVEJOY, L.S. MEDFORD, ORE.

SCALE: 1"=200' OCT. 12, 1954

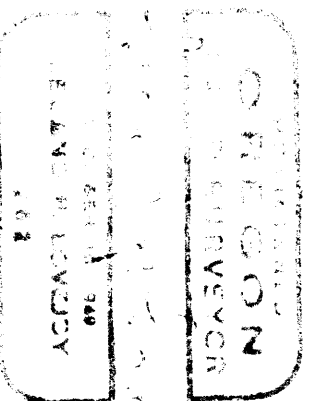

Survey Narrative to Comply with Section 87-330

State of Oregon Law (1947)

Survey for: The Pacific Telephone and Telegraph Company
509 S. W. Oak Street
Portland 4, Oregon

Purpose of Survey: To run out property boundaries.

Survey Location: Sections 33 and 34, Township 40 South,
Range 2 East, Willamette Meridian,
Jackson County, Oregon.

Survey Procedure: Found section corner, Sections 27, 28, 33
and 34, Township 40 South, Range 2 East,
Willamette Meridian. Set 1" galvanized
iron pipe at all property corners.

Leland P. Lovejoy
Registered Land Surveyor

Work completed November 10, 1954.

