

REGISTERED
 OREGON
 LAND SURVEYOR

SURVEY IN SEC. 27 & 34, T.37S., R.1W.


Edward A. McGinty 2/4/55

FOR
 DR. BRANDT BARTELS

JULY 10, 1953
 EDWARD A. MCGINTY
 301

BY EDW. A. MCGINTY
 MEDFORD, OREGON

SCALE, 1" = 300'
 FEB, 4, 1955

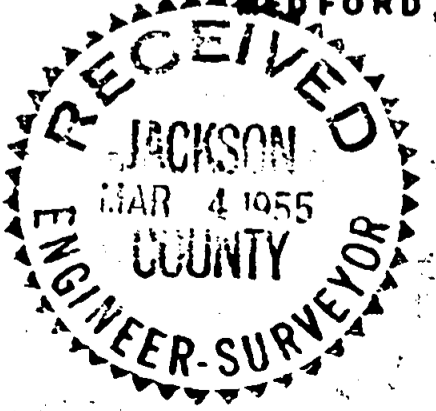

Survey Narrative to comply with the O.R.S. 209-205 and O.R.S. 209-120

Survey for: B. Brandt Bartels

By: Edward A. McGinty

BASIS OF BEARING:

Solar observation

PRECEDENCE OF SURVEY:

Found SE, SW corner D.L.C. 57 T37S, R1W. The SW corner tie to bronze disc. being South 29°15'30" East 329.55 feet (Recorded at South 29°59' East 333 feet) SE corner 2" gal. pipe recently re-established by Co. Surveyor, not on record at the time of survey. Found NW corner D.L.C. 57 from County road records 2" pipe. Found SW corner DIC 58, sandstone from Co. roads, found measuring from 1/4 corner between 27 & 34 measuring North to Approx. SE cor. DIC 58, found large dead Oak stump being unquestionable as evident bearing tree, apparently scribe chopped away, corner fell in edge of road where grading had occurred in the past. See re-est. Corner 1913.

I thus established the West line of deed Prob-Journal Vol. 47, page 222.

SOLAR OBSERVATION:

Place: SW corner DIC 57, T37S, R1W - *Sec. 27 & 34*

Date: February 27, 1955, 4:05 PM, PST
February 27, 1955, 24 hr. 05 m, GWT

Declination: 8°20'07"

Refraction: 0°03'

Latitude from Map: 42°18'26"

Vertical Angles: 18°16'30"
17°49'00"
16°58'30"

