
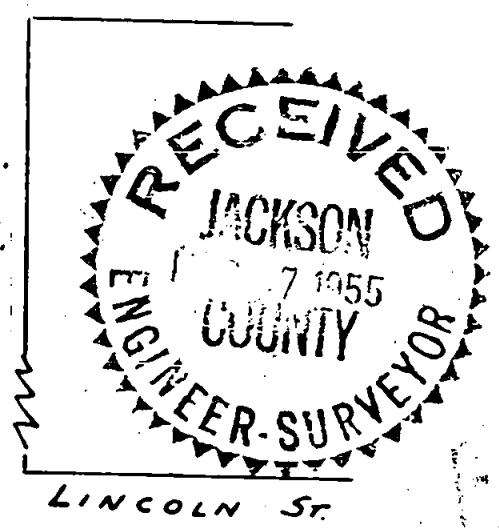
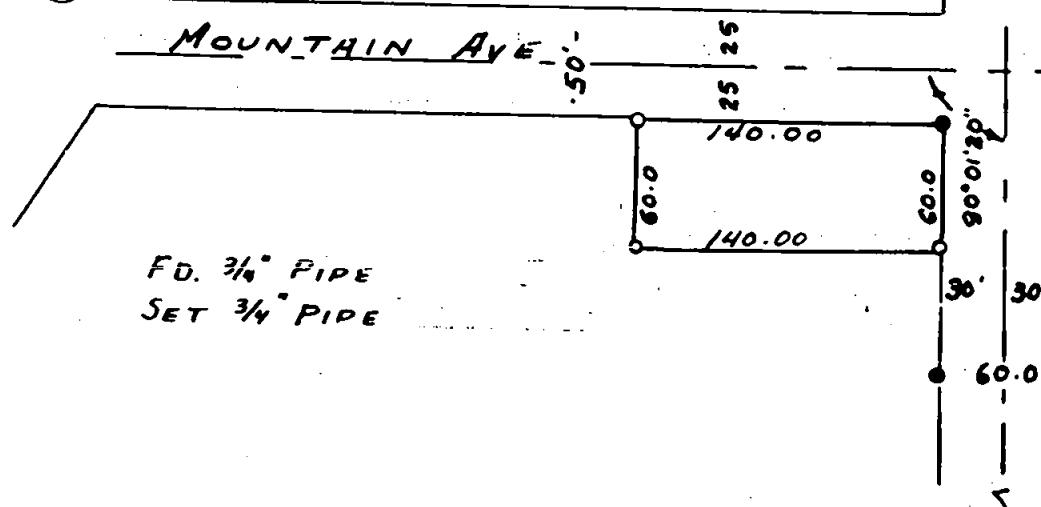


693


F. Bolt

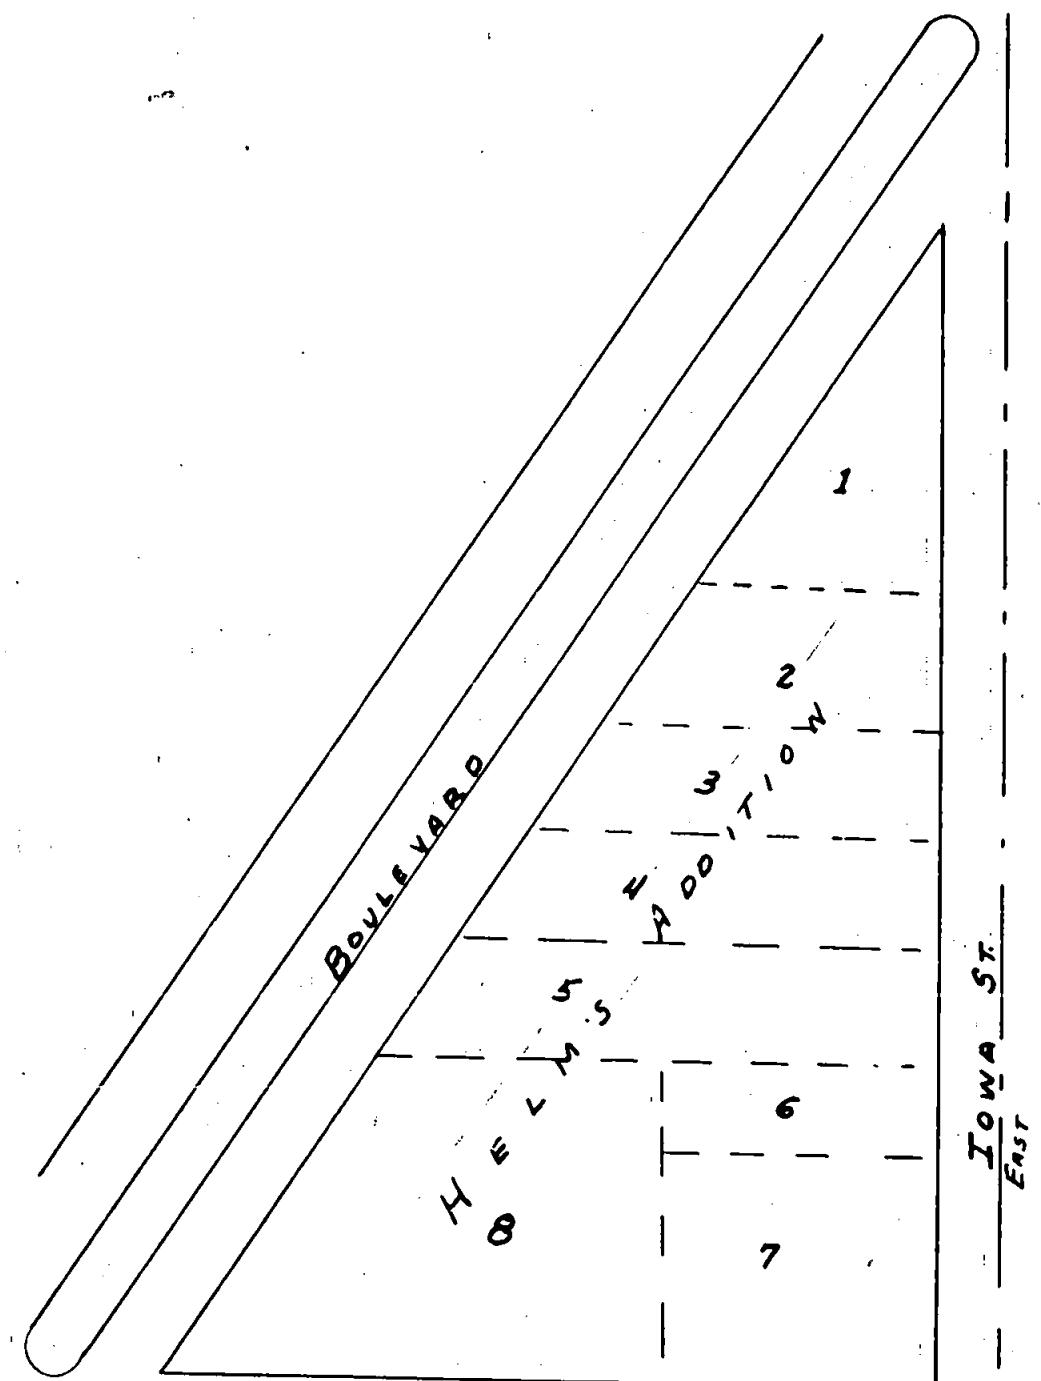


SURVEY IN CITY OF ASHLAND  
FOR  
A. H. GARDNER

By EDW. A. MC GINTY  
MEDFORD, OREGON

SCALE 1" = 100'  
MARCH 5, 1955

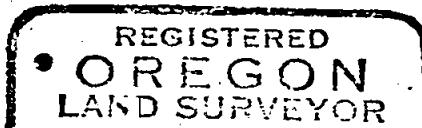

Edward A. McGinty 3/5/55

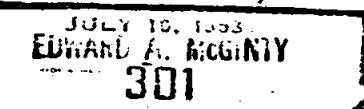

Survey No.

693

Survey Narrative to comply with the O.R.S. 209-205 and O.R.S. 209-120


Survey for: Gardner, A.H.

By: Edward A. McGinty

PRECEDENCE OF SURVEY:

Determined centerline of Iowa street and Mountain Avenue from City records of Ashland, and turned angle at intersection of 90°01'20" (original record 90°00')

Intersection of Main & Mountain from reference points, Mountain & Iowa from reference points, Iowa & Boulevard found bolt, Lincoln & Iowa 3/4 inch pipe 10 inches deep. I also found a pipe on the South line Iowa street end pipe at the intersection of South line Iowa and East line of Mountain Ave.

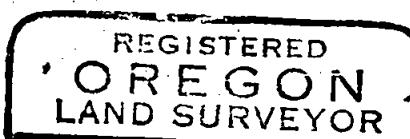

Edward A. McGinty 3/2/55

JULY 10, 1955  
EDWARD A. McGINTY  
301

