



S.W. Cor. Sec. 20.

PLAT SHOWING SURVEY OF PROPERTY FOR W.D. PETTIS  
 In Lot 2, Sec. 20, Twp. 36 S., R. 4 W. of Willamett Merdn.  
 Jackson County, Oregon

This is to certify that I have surveyed the property of W.D. Pettis in Lot 2, Sec. 20, T. 36 S., R. 4 W. of W.M. and that the accompanying map accurately represents the survey of same and that all of the improvements on same are within the boundary lines.

SCALE: 1" = 30'

Feb. 14, 1955.

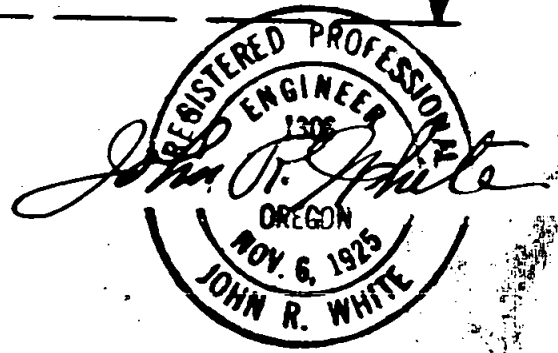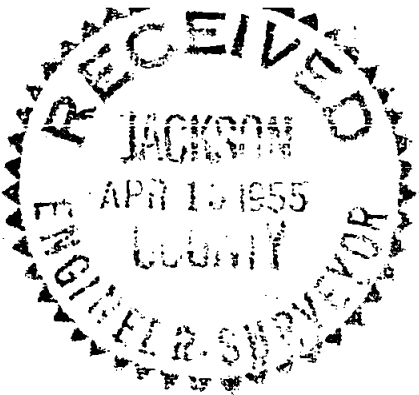

April 13, 1955

Mr. John R. White  
County Surveyor  
Court House  
Grants Pass, Oregon

Dear Sir:

I received your tracing and blue print of a plat showing survey of property for W. D. Pettis in Lot 2, Section 20, Township 36 South, Range 4 West, Willamette Meridian. I am very disappointed in finding that there are no bearings or angles to be found on the map. To me no map is complete without that information.

In Jackson County, we require a narrative to accompany the map; said narrative to be in accordance with Oregon Revised Statutes 209.250. Mark E. Boyden has filed a number of surveys with narratives, and I am herewith enclosing a copy of one of his which I think meets with the intention of the statutes. We also like to have these narratives in duplicate and on legal size paper if possible.

Before filing your map for official record, I would be pleased to have your authority to return it to you in order that you may show the bearings and/or angles necessary.

Very truly yours,

Paul B. Rynning  
County Surveyor

PBR:op

Enclosure