



b1L

719

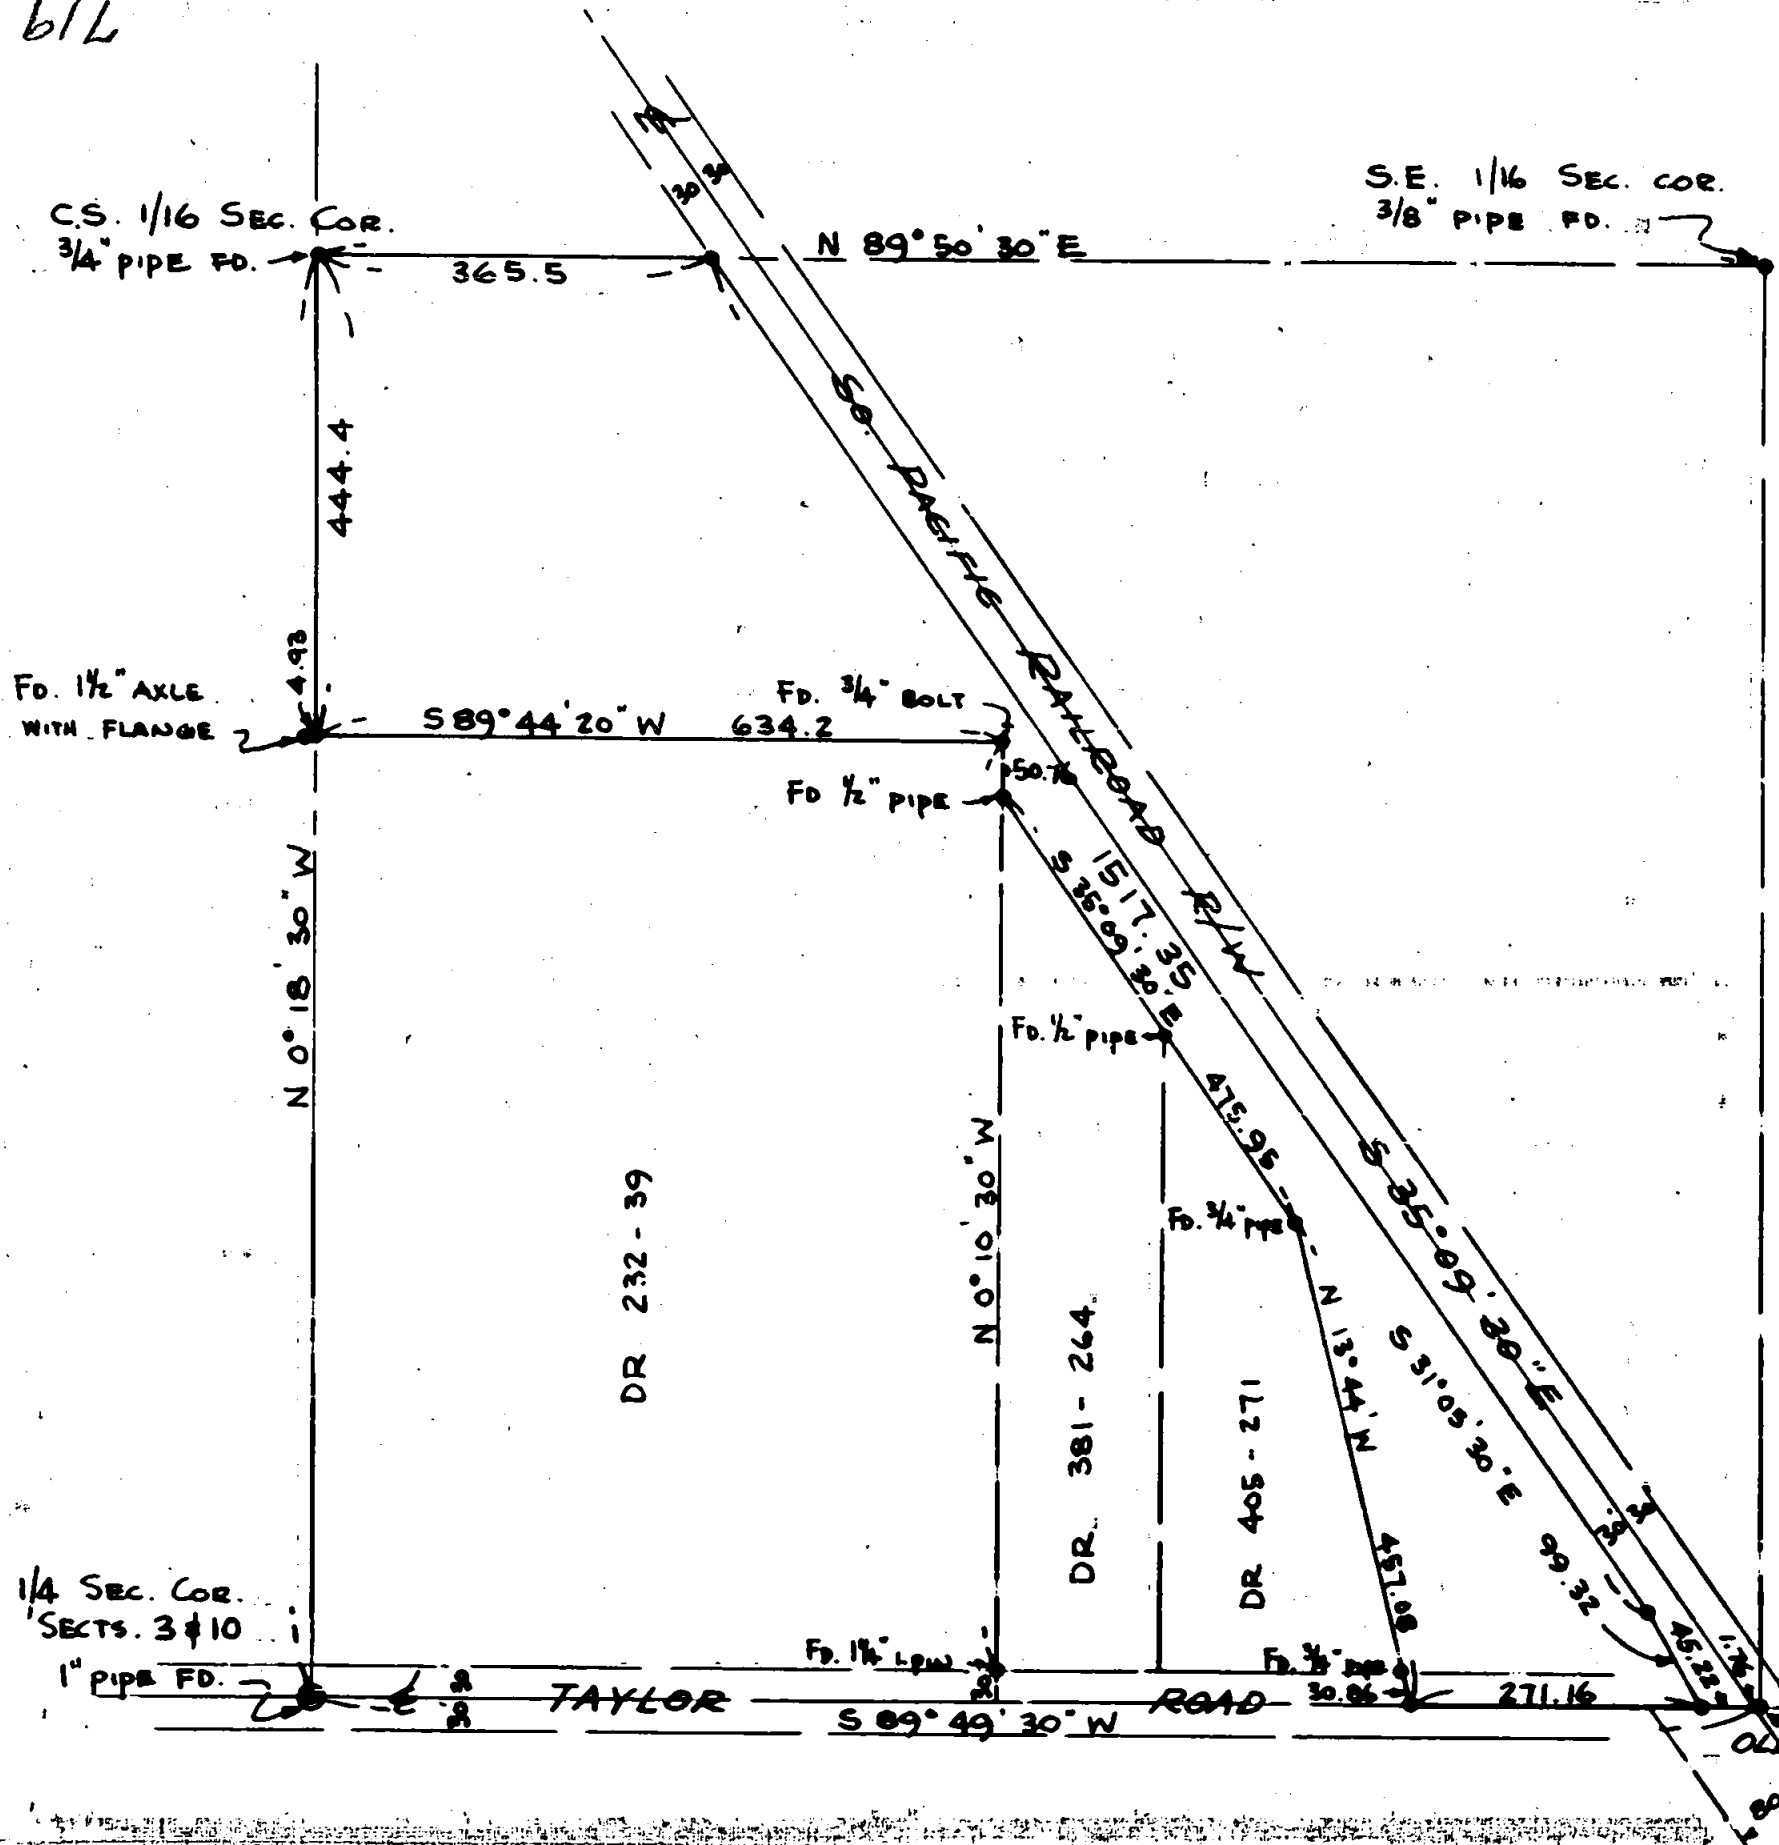

SURVEY FOR
 MRS. ANZONETTA HESSELGRAVE
 LOCATED IN SEC. 3, T37SR2W.
 BY: BOYDEN & BOYDEN
 MAR. 1955.

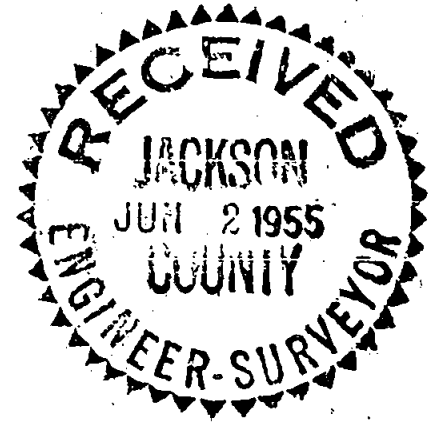

SCALE: - 1" = 200'

○ FOUND IRON PIPE
 ● IRON PIN

REGISTERED
 OREGON
 LAND SURVEYOR

Mark E. Boyden
 NOVEMBER 1951
 MARK E. BOYDEN
 281

719

Survey Narrative to comply with Paragraph 209.250,
Oregon Revised Statutes.

FOR: Mrs. Anzonetta Hesselgrave

PURPOSE: To monument and describe the outside boundaries of the Hesselgrave property, located in Section 3, Township 37 South, Range 2 West.

PROCEDURE: The subject property ownership is described in Deed Records Volume 173, Page 450; less Deed Records Volume 116, Page 46, Deed Records Volume 381, Page 264, and Deed Records Volume 405, Page 271.

Previous surveys by this office established the boundaries of Deed Records Volume 381, Page 264 (see Survey No. 274) and Deed Records Volume 405, Page 271 (see Survey No. 695), which monuments were recovered on this survey.

Found several control points as described in Deed Records, Volume 173, Page 450 and determined said description does not fit the subdivisional lines of Section 3 as the same are now established (see Survey No. 248).

Therefore, replaced the description Deed Records Volume 173, Page 450 as the same was previously monumented on the interior boundaries and where said description lapped the quarter-quarter Section boundaries, the new established subdivisional lines were used to control the subject property boundaries.

March 1955

