

076

760

N.W. Cor. D.L.C. 58
(Record)

30' 30'

756.40'

50.0'

PACIFIC HIGHWAY
610'

304.40'

E 125.90'

Surveyed
Oct. 1955

125.90'

90° 09'

LOT 20

0.723 AC ±
Surveyed
July 1954

SET 1/2" Steel Pins

SCALE: 1" = 100'

125.90'


S.E. Cor.
LOT 20

PITT VIEW AVENUE

BOUNDARY LOCATION
Property Situate in Lot 20
AMENDED PLAT of LOTS 3 to 10 incl.
PITT VIEW SUBDIVISION
JACKSON COUNTY, OREGON

Found Iron Pipe

N.E. Cor. Lot 19

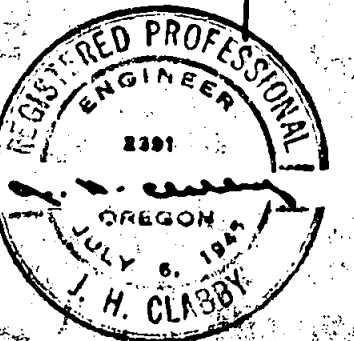

J.H. CLABBY, C.E. JULY 1954 MEDFORD, ORE. T. 378, P.A.W. AMENDED OCT. 1955

21-54

Survey Narrative to Comply with Section 87-330, 1947 Oregon State Laws.

Survey for: J. W. Langston

Location: Pittview Subdivision - Amended Plat

Purpose of Survey:

To locate and describe a parcel of land as designated by owner.

Procedure: Found points established on a previous survey (July 1954).

Extended the east and west lines 166.70 feet north and set corners for the additional parcel.

J. H. Clabby

October 1955

