

596

765


CRATER LAKE HIGHWAY
N 44° 52' E 400.00'

N 89° 59' 51" E
166.21'


SOUTH
203.50'

S 89° 59' 51" W 448.39'

16
17 196'

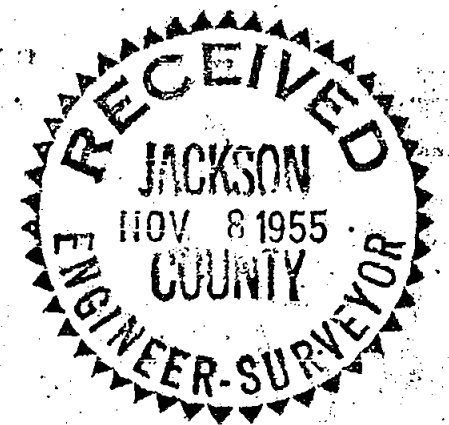

BOUNDARY LOCATION
Property Situate in
Sec. 16, Twp. 36 S., R. 1 W., W. M.
JACKSON Co., OREGON
J. H. CLABBY CIVIL ENGR.
SEPT. 1955 SCALE: 1"=50'

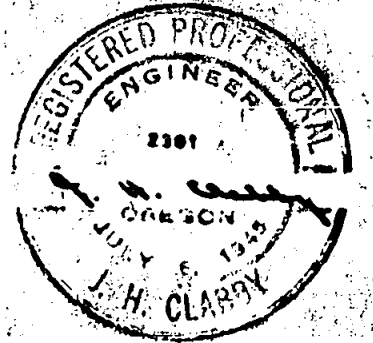

Survey Narrative to Comply with Section 87-330, 1947 Oregon Law.

Survey for: Bud Hoover

Location: Section 16, Township 36 South, Range 1 West, Willamette Meridian, Jackson County, Oregon.

Purpose of Survey:

To locate and describe a 2-acre parcel with 400 foot frontage on Crater Lake Highway.

Procedure:

Found iron pipe on south line Section 16 at its intersection with easterly right of way of Crater Lake Highway.

Found iron pin some 1300 feet more or less east.

Set southeast corner on section line 448.39 feet easterly from said iron pipe at intersection. Turned north and set iron pin at 283.50 feet for the northeast corner. From point of beginning ran North 44° 52' East 400.00 feet and set northwest corner. Chained distance from northwest corner to northeast corners 166.21 feet which is the required distance.

September 3, 1955

J. H. Clabby

