

# SURVEY FOR L. W. BUONOCORE

LOCATED IN BLOCK 76  
ORIGINAL TOWN (NOW CITY)

MEDFORD, OREGON

BOYDEN AND BOYDEN


JUNE 1955




REGISTERED  
OREGON  
ENGINEER-SURVEYOR

*Mark E. Boyden*  
NOVEMBER 9, 1951  
MARK E. BOYDEN  
281

5TH. ST. CON. MON.

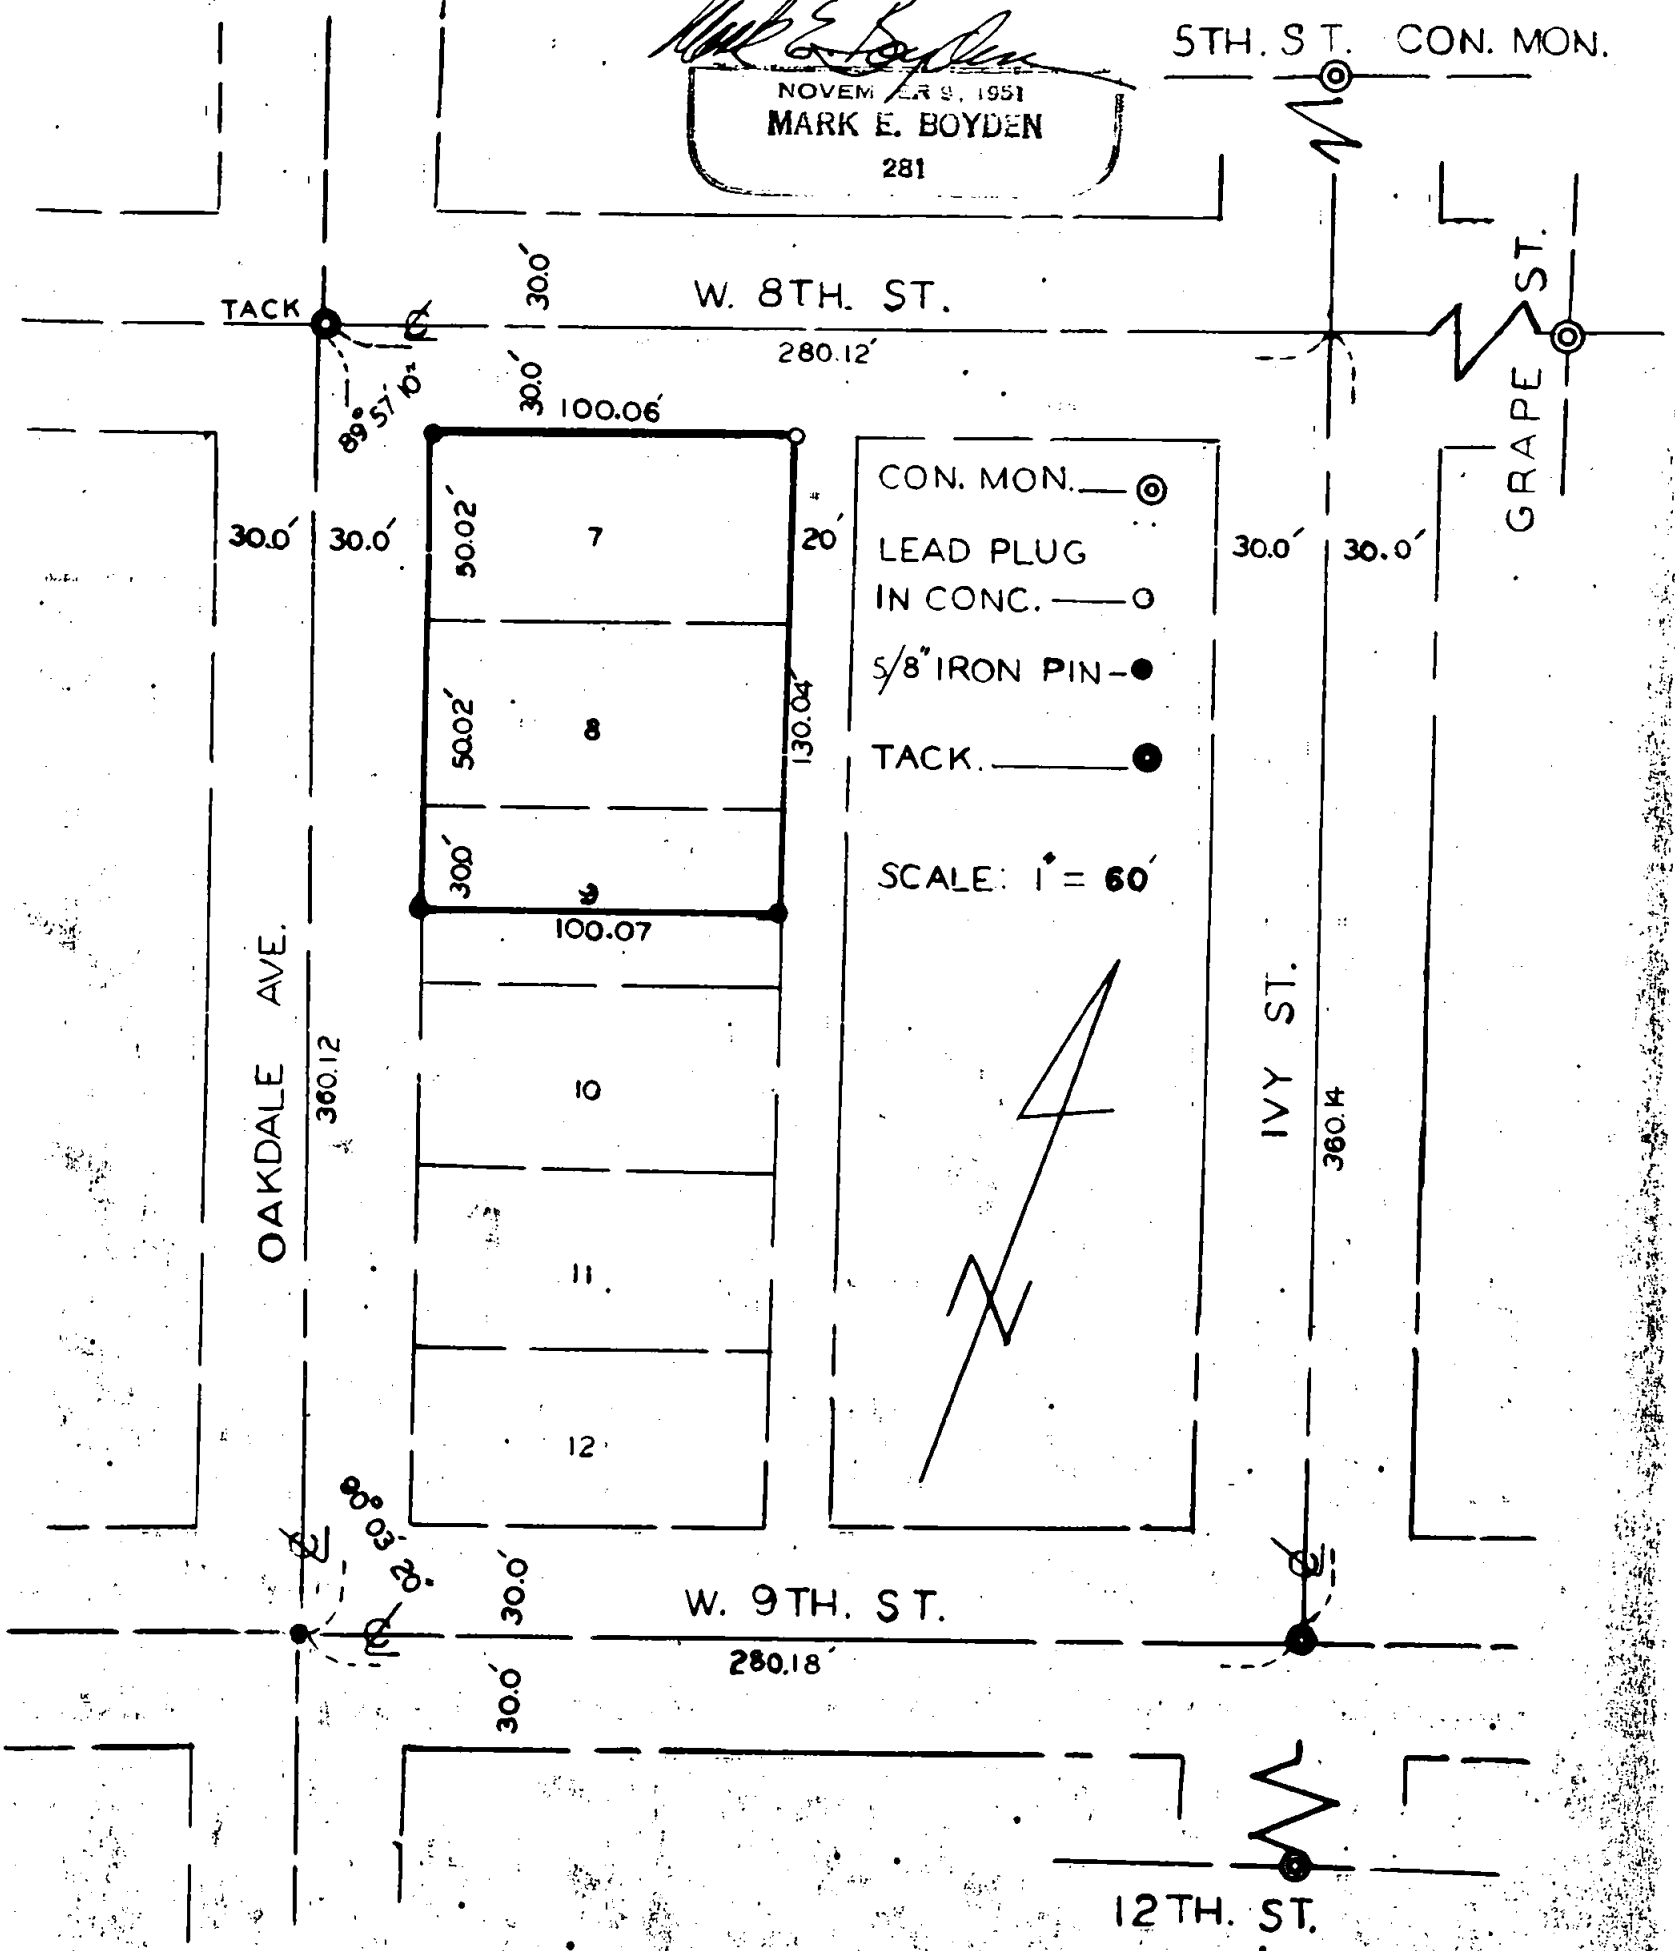

- CON. MON. — ⊙
  - LEAD PLUG IN CONC. — ○
  - 5/8" IRON PIN — ●
  - TACK. — ●
- SCALE: 1" = 60'

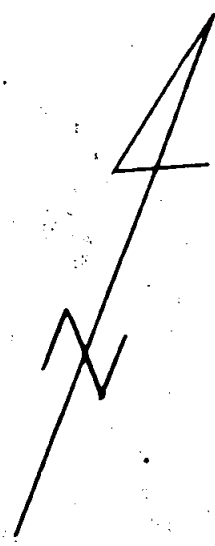

Survey Narrative to comply with Paragraph 209.250,  
Oregon Revised Statutes

SURVEY FOR: L. W. Buonocore

Purpose: To monument the outside boundary of the Buonocore property, being Lots 7, 8, and the Northerly 30 feet of Lot 9, Block 76, Original Town (now City) of Medford, Oregon.

PROCEDURE: Recovered the city-accepted control monuments for the Street centerline intersections and cut-in the center at 8th and Ivy Streets from monuments as shown on the attached map.

Enclosed the block with angles and distances on the street centerlines and proportioned the lot corner locations accordingly.

August 1955

