


982786

SURVEY FOR:
F. A. BLAAR
Located in Sec. 33, T36S R1W
By: **BOYDEN & BOYDEN**
November, 1955

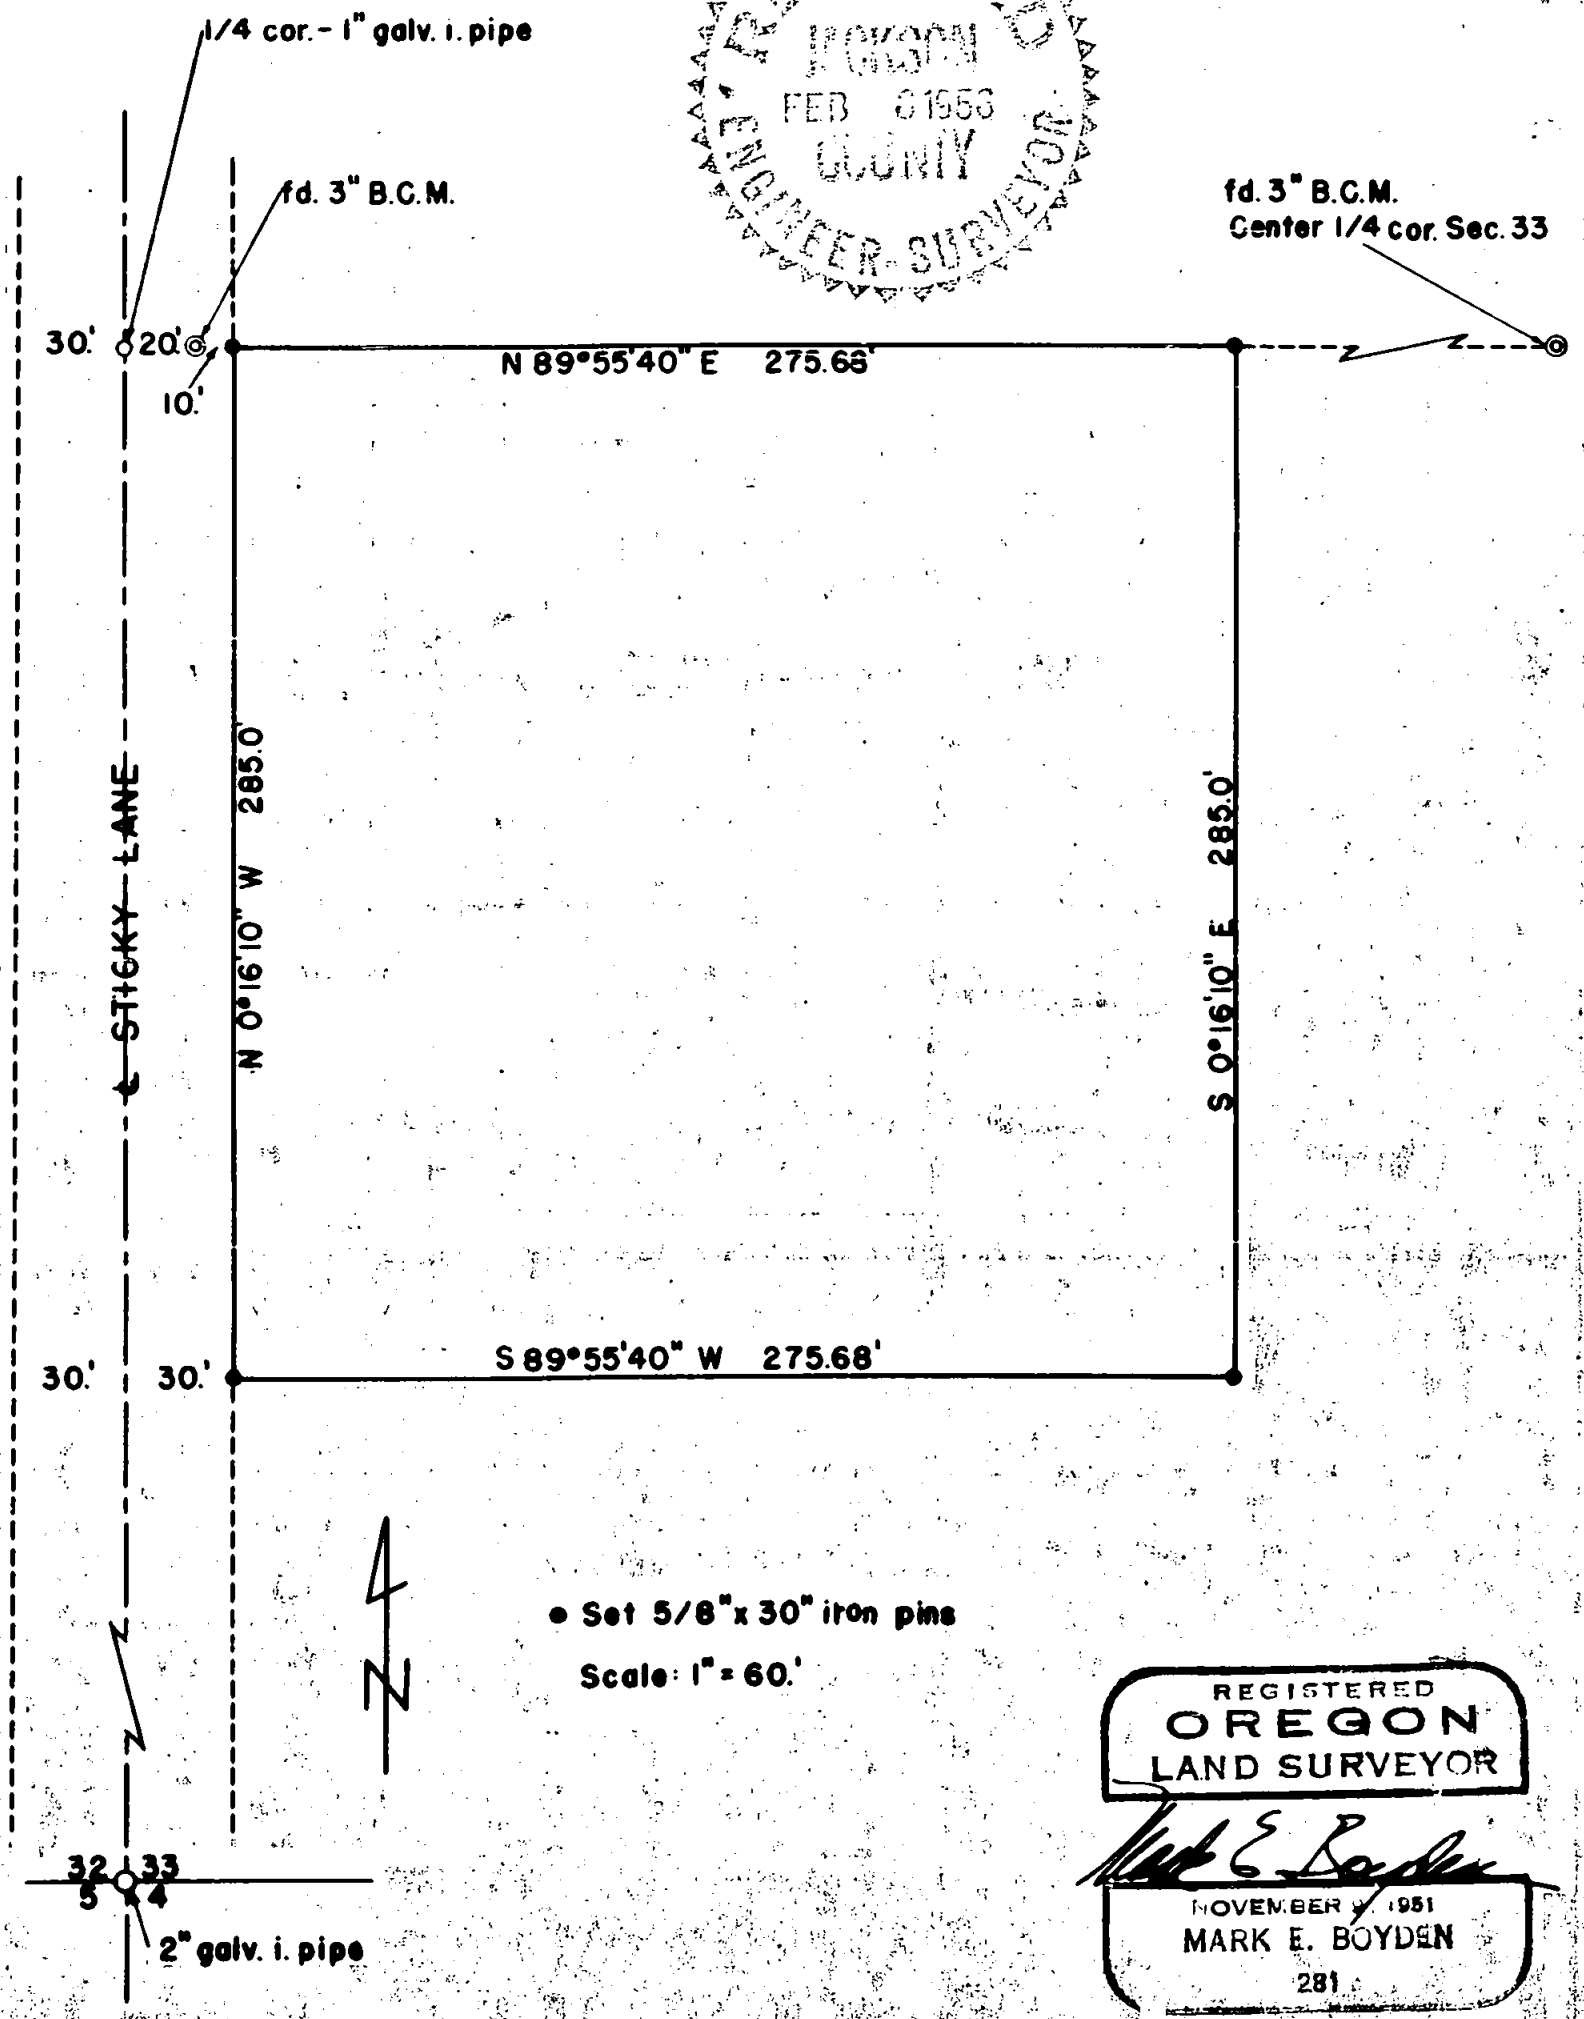

REGISTERED
OREGON
LAND SURVEYOR

Mark E. Boyden

NOVEMBER 9 1955
MARK E. BOYDEN
281

786

Survey Narrative to comply with Paragraph 209.250,
Oregon Revised Statutes

FOR: F. A. Blaar

PURPOSE: To monument and describe a 2-acre tract in the Northwest corner of the Blaar property, located in Section 33, Township 36 South, Range 1 West.

PROCEDURE: The brass-capped monuments found on this survey were set by County Surveyor A. T. Brown some 40 years ago to reference and monument the 1/4 corner to Sections 32 and 33 and the Center of Section 33 respectively. Accepted said control monuments and monumented the tract as shown on the attached map. Meridian control from TIMMONS SUB-DIVISION Sticky Lane road tangent.

November 1955

REGISTERED
OREGON
LAND SURVEYOR

Mark E. Boyden

NOVEMBER 9, 1955
MARK E. BOYDEN
281

RECEIVED
JACKSON
FEB 6 1956
COUNTY
ENGINEER-SURVEYOR