


793

793

KOGAP LUMBER INDUSTRIES
SEC. 31, T. 37 S., R. 1 W.
BOYDEN & BOYDEN NOV. 1955

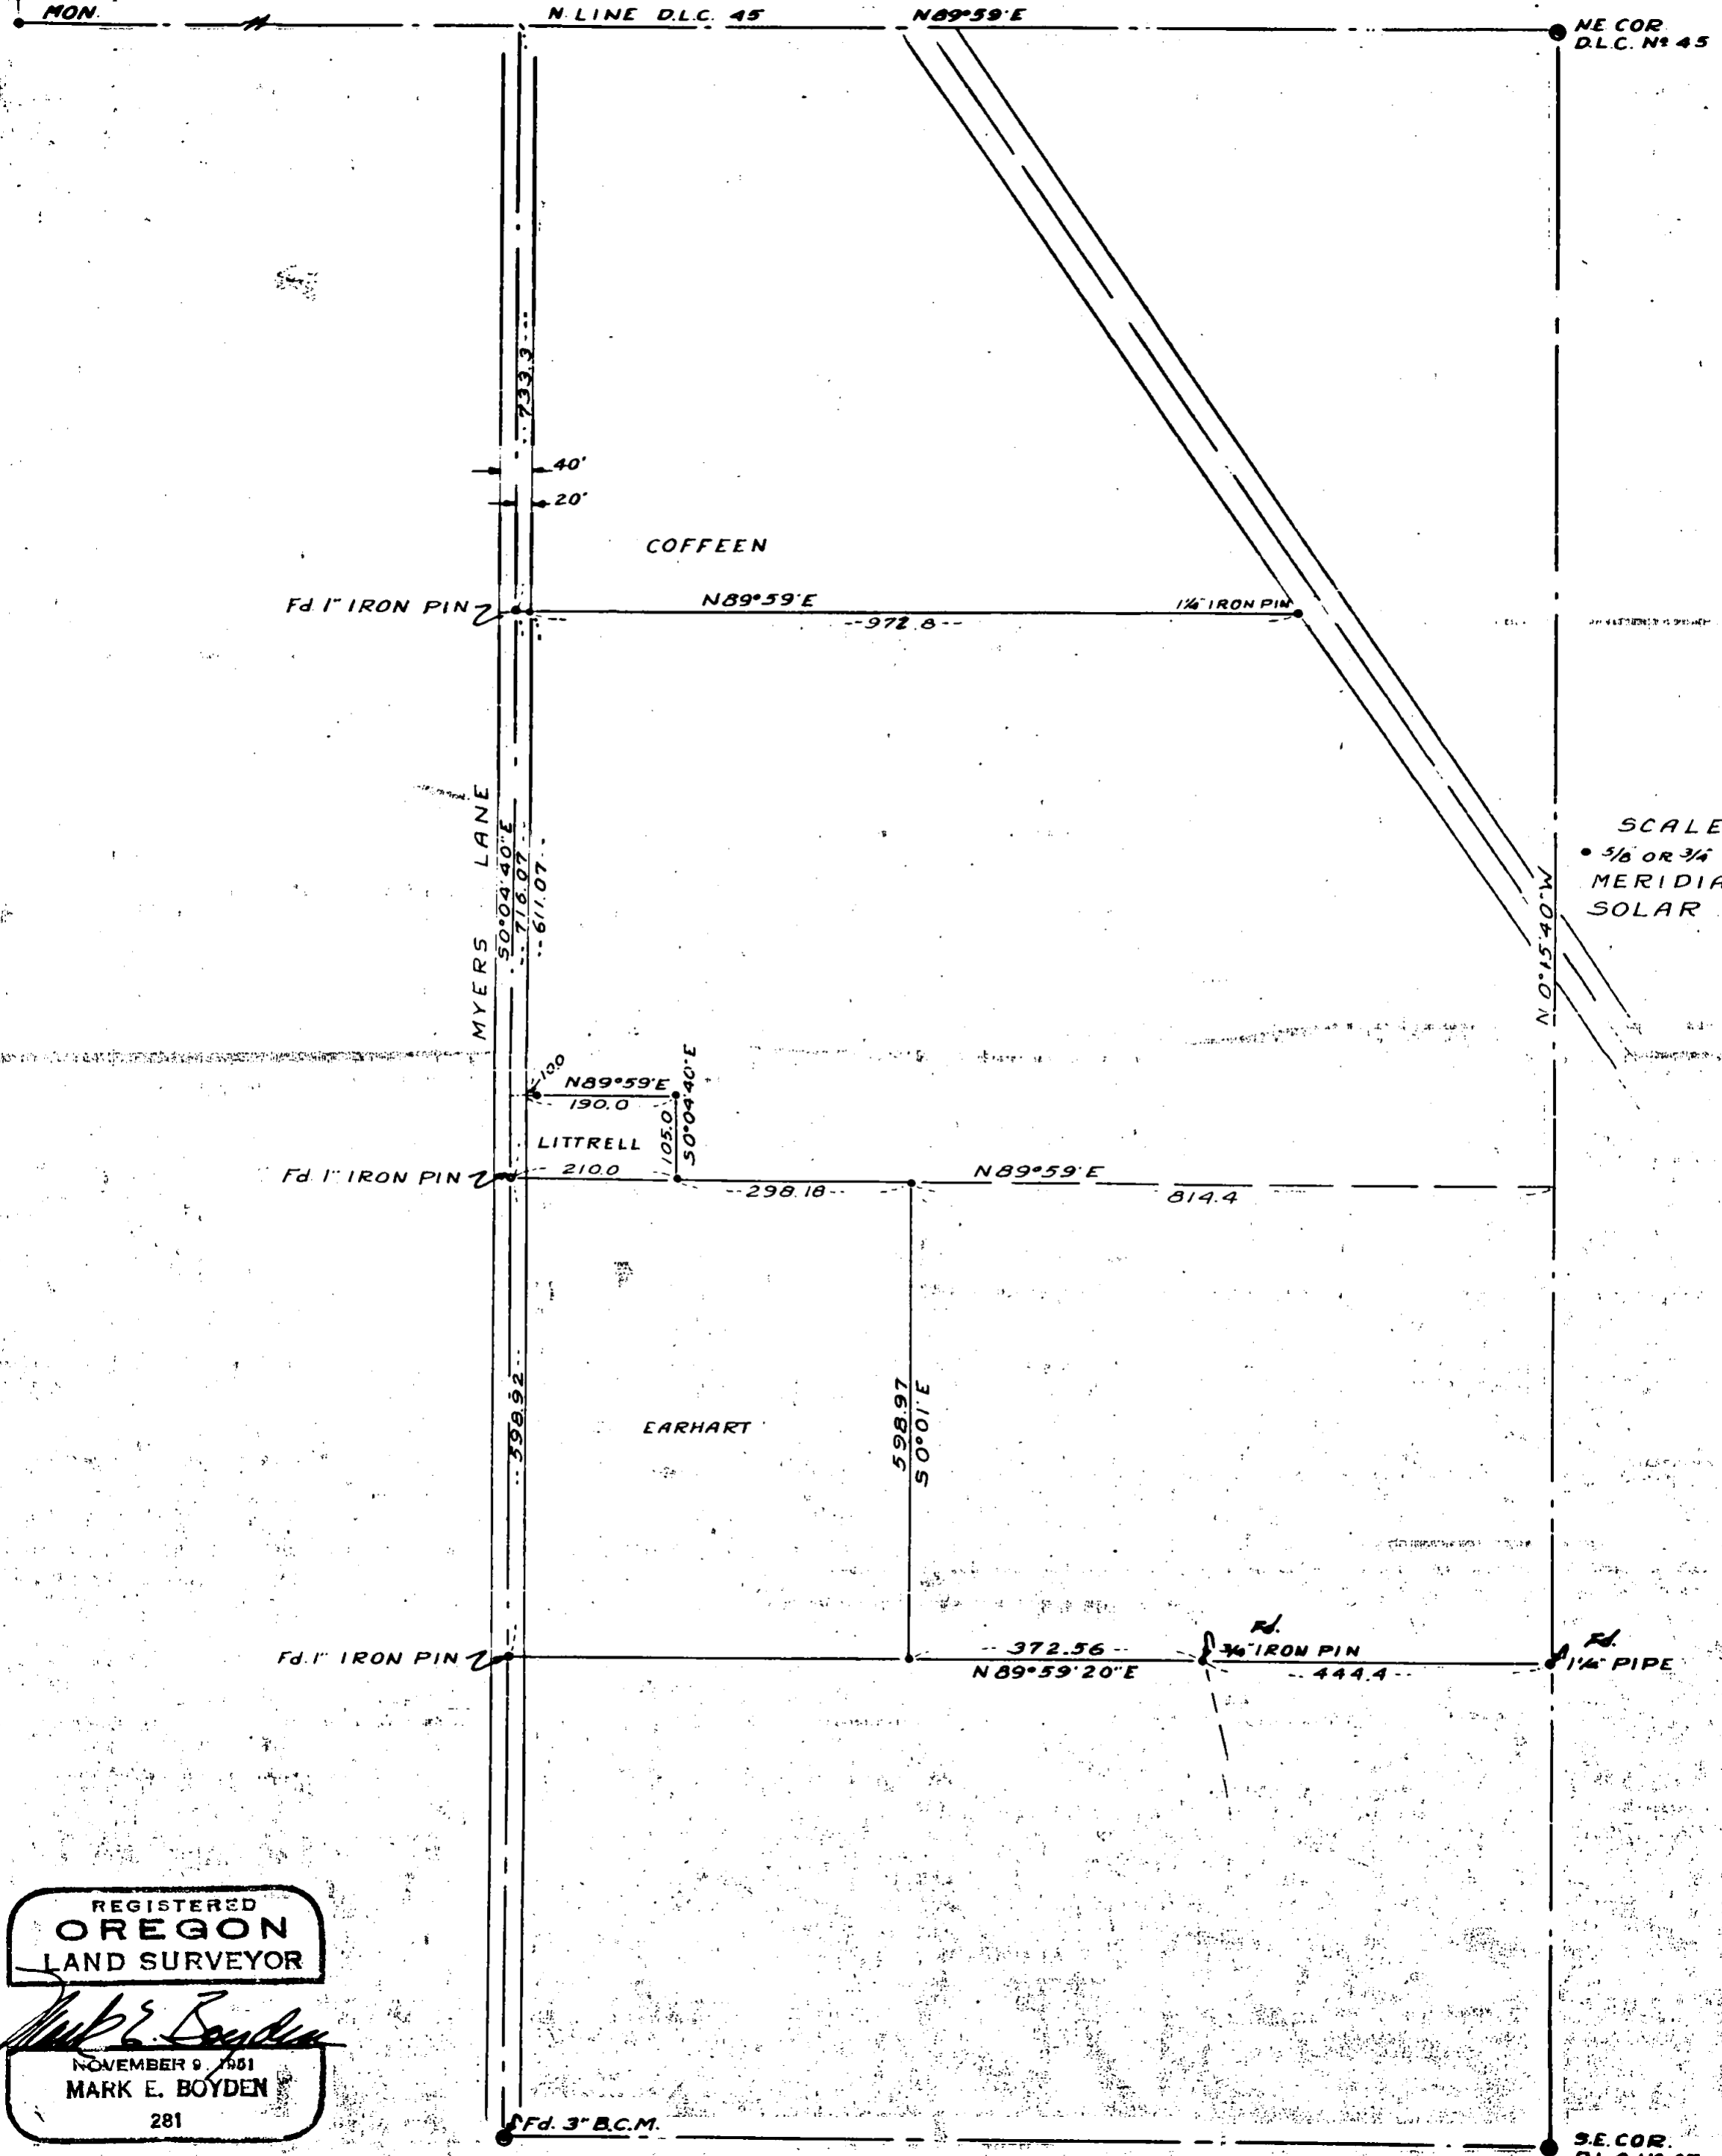

SCALE ~ 1" = 200'
• 3/8 OR 1/2 IRON PIN
MERIDIAN BY
SOLAR OBSN.

REGISTERED
OREGON
LAND SURVEYOR

Mark E. Boyden

NOVEMBER 9, 1951
MARK E. BOYDEN
281

793

Survey Narrative to comply with Paragraph 209.250,
Oregon Revised Statutes

SURVEY FOR: KOGAP Lumber Industries

PURPOSE: To establish several boundaries of the KOGAP ownership located in Section 31, Township 37 South, Range 1 West.

PROCEDURE: These tracts are located in and are a portion of the Harry L. Butler property which was surveyed and the major east-west division lines established and monumented by this office in 1929. Three of these iron pin monuments along the centerline of Myers Lane were recovered, also the 1 $\frac{1}{2}$ " iron pipe on the east boundary of D.L.C. No. 45. From these original controls, the intermediate points of more recent descriptions were established as shown on the map to accompany this report.

November 1955

