

Survey for

MRS. A. E. ORR

Located in Sec. 29, T.37S.R.I.W. W.M.  
Medford, Oregon

By: Mark E. Boyden Jan. 1956.

REGISTERED  
**OREGON**  
LAND SURVEYOR

*Mark E. Boyden*  
NOVEMBER 1951  
MARK E. BOYDEN  
281

962796

A D D.

ROAD

BARNEBURG

NORTH

CROWN

SNW cor. D.L.C. No. 52  
Conc. Non.

962

S 87° 32' E 130.37'

128.35'

North

162.05'

South

N 89° 54' 20" W

BUSH

130.25'

1120.99'

164.02'

South

434.54'

South


1564.76'

1/4 Sec. cor.  
Secs. 20 & 29  
1" iron pipe in conc.

Scale:  
1" = 30'  
• Set  
3/4" iron bolt

1/4 Sec. cor.  
Secs. 20 & 29  
1" iron pipe in conc.

1 d. iron pin & HILLCREST RD.  
8 ft MODOC

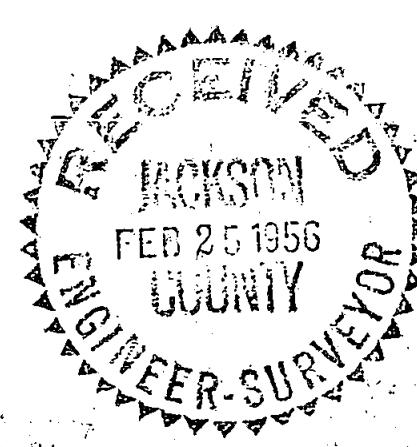

- S 89° 53' 20" W 78.79' - S 89° 53' 20" W 51.46' -

South 1.50'

AVE.

SURVEY NO. 796

Survey Narrative to comply with Paragraph 209.250,  
Oregon Revised Statutes

FOR: Mrs. A. E. Orr

PURPOSE: To survey a portion of the Orr property located in Section 29, Township 37 South, Range 1 West, as directed.

PROCEDURE: The subject property is located in unplatte land and tied to the North 1/4 corner of said Section 29 by way of the centerline of the County Road (now Hillcrest Road.) The center line of this portion of said road was established on a line between the Northwest corner of D.L.C. No. 52 and an iron pin at the intersection of said road with Modoc Avenue. The measured distance from said 1/4 corner South to the above established centerline was found to be 3.70 feet less than the Deed Record tie, thus causing the record North boundary of the adjoining property to overlap the improvements on the Orr property.

The East and West boundaries were established according to the record description and the North and South boundaries as directed. Title to the new South boundary to be established by exchange of deed. Iron pin monuments were set for all corners of the subject tract as shown on the map to accompany this report. Meridian was determined by solar observation.

January 1956

