

D.L.C. 46

D.L.C. 45

FD. I. PIN NEAR N.W. COR., D.L.C. 45

S.E. COR. D.L.C. 46

S 0°13'10"W

84.96'

166.96'

S 0°11'30"E

25'

25'


N 89°22'40"W  
277.85'

277.85'  
S 89°22'40"E

M 0°11'30"W  
166.96'

CO. RD. REC. S 0°15'E

I. PIN 18' N.  
OF BRIDGE

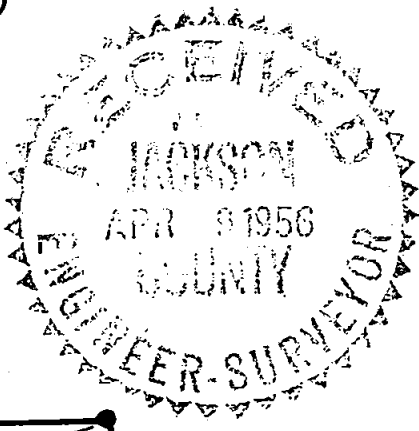

REGISTERED  
OREGON  
LAND SURVEYOR

*Edward A. McGinty*

JULY 10, 1953  
EDWARD A. MCGINTY  
301

SURVEY IN D.L.C. 45, T.38 S., R.1 W., W.M.

FOR  
CHRISTIAN WOLFF

BY EDW. MCGINTY  
MEDFORD, OREG.

SCALE 1" = 100'  
MARCH, 1956

Survey Narrative to Comply with ORS 209-205 and ORS 209-120

SURVEY FOR: Christian Wolff

BY: Edward A. McGinty

BASIS OF BEARING:

Solar Observation

PRECEDENCE OF SURVEY:

Determined the center line of County Road from roads-records. Finding 1/2 inch Iron pin near NW cor. DLC 45, near surface. Found 1/2 inch Iron pin near surface at the SE cor. DLC 46, 1 inch pipe 25.00 feet westerly and bolt 25.00 feet Easterly.

Found 1/2 inch pin near surface ~~at~~ approx. 18 feet north bridge.

Set 5/8 inch Iron pin's on East line Co. Rd. shown on map.

Set 1 1/4 inch axle at NE cor. of parcel.

Set 1 inch pipe at SE cor. of parcel.

SOLAR OBSERVATION:

Place: † 200 feet South of SE cor. DLC 46  
 Time: April 3, 1956 3:45 PM, PST  
 Declination: 5°35'45" North  
 Elevation: 1500 feet †  
 Vertical angles: 32°49', 31°10', 30°34'20"  
 Latitude: 42°17'  
 Parallax and refraction: 0°01'20"

REGISTERED  
 OREGON  
 LAND SURVEYOR

*Edward A. McGinty*

JULY 10, 1955  
 EDWARD A. MCGINTY  
 301

