


SURVEY OF M.&B. PROPERTY
 IN SEC. 25, T. 37 S. R. 2 W. (WM.)
 IN CITY OF MEDFORD, OREGON
 FOR WILLIAM BROOKS
 MARCH 10, 1956

REGISTERED
OREGON
 LAND SURVEYOR
L. N. Dow
 MAY 6, 1949
 L. N. DOW
 251

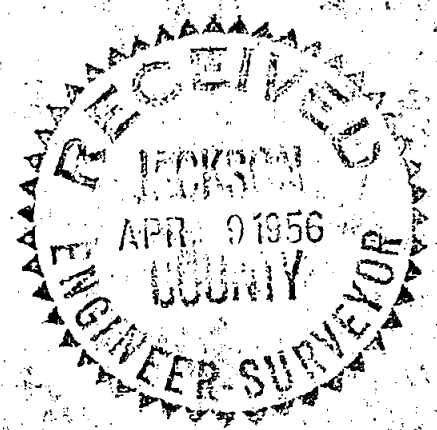

Note- Mon case at approx center Second & Oak is empty
 City Book 60 P 25 pin in pavement 1 1/2' S.E. Mon. case not found

96

Written narrative to accompany plat for survey no.

Survey for Mr. William Brooks, 121 Oak St. Medford, Oregon.

Date of Survey March 10, 1956.

Purpose to set corners for metes and Bounds property facing Oak Street.

Having the concrete monument for the 1/4 corner located on Jackson Street 262.02 feet West of the concrete monument in case at the center of Oak Street and W. Jackson St

Next located the concrete monuments for the corners to the Consolidated Addition No.4 and set up a center for Oak Street. Please note that the mon case at Oak and Second has no point and the City Records state that the true point falls elsewhere.

Having all monuments located and the center of Oak Street well defined I then set the corners for the tract as shown on the plat.

REGISTERED
OREGON
LAND SURVEYOR

L. N. Dow

MAY 6, 1949
L. N. DOW
251

RECEIVED
JACKSON
APR 9 1956
COUNTY
ENGINEER-SURVEYOR