


SURVEY FOR MR. HAROLD HEWLETT
OF THE EAST LINE OF LOT 10 BLOCK 4 EASTWOOD
AT 1533 OREGON AVE. MEDFORD, ORE.
SCALE 1" = 10' DATE MARCH 25, 1956

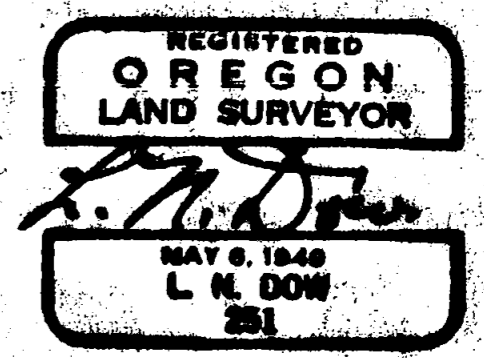

OREGON AVENUE

Written narrative to accompany plat for survey No.

Survey for Mr. Harold Hewlett, 1533 Oregon Avenue, Medford, Oregon.

Date March 25, 1956.



Purpose to locate East line of Lot 10 Block 4, Eastwood Subd. *Medford*
and measure location of retaining wall.


Let pins on Oregon Avenue at the west line of Lot 12, at the corner of 12-11 and at the corner of 11-10 were found and checked for location, the 1 1/4" pipe under the corner of the retaining wall at the northwest corner of lot 10 was located and the angle turned from the front line to this pin, angle turned is 90° which checks plat angle.

I then set a 5/8" x 30" Bar at the southeast corner of Lot 10, and a lead plug in a block wall for the northeast corner of Lot 10 and made a careful location map of the retaining wall between lots 10 and 9 as shown on the plat.



L. N. Dow

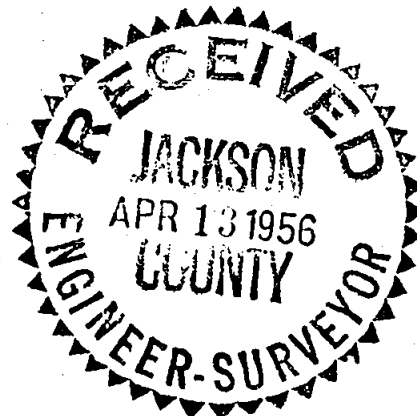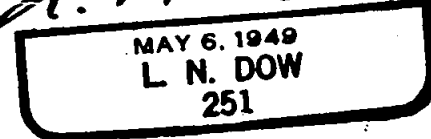

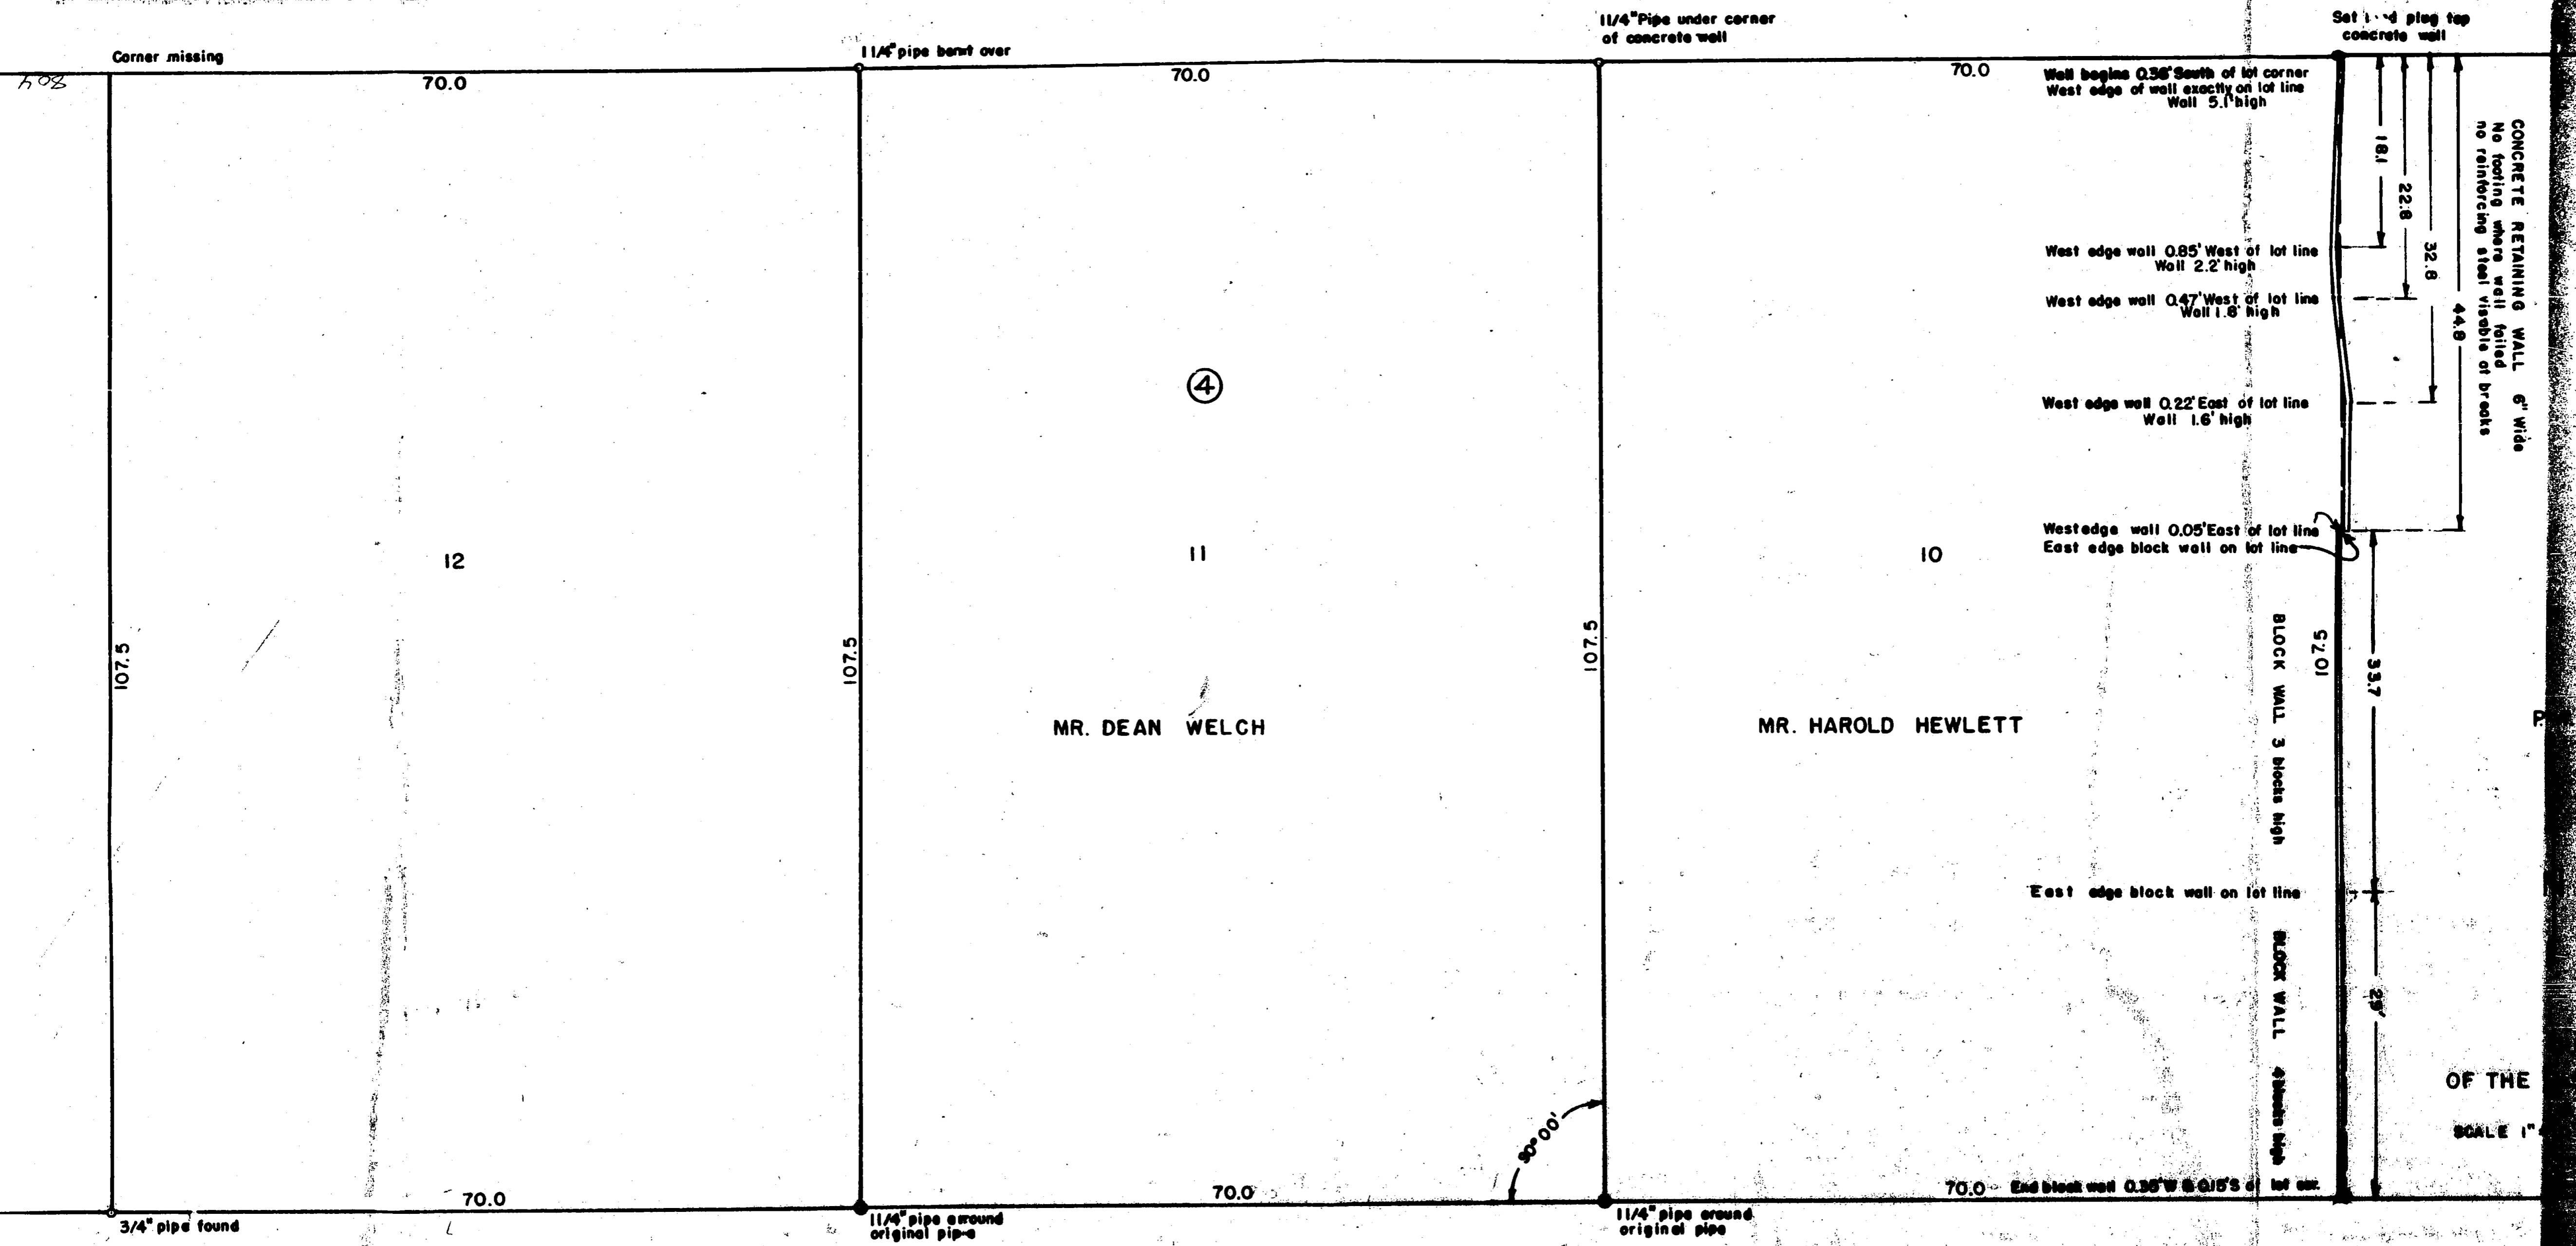

508

Corner missing

70.0

1 1/4" pipe bent over

70.0

1 1/4" Pipe under corner of concrete well

70.0

Well begins 0.36' South of lot corner
West edge of well exactly on lot line
Wall 5.1' high


Set 1 1/4" plug top concrete well

West edge wall 0.85' West of lot line
Wall 2.2' high

West edge wall 0.47' West of lot line
Wall 1.6' high

West edge wall 0.22' East of lot line
Wall 1.6' high

West edge wall 0.05' East of lot line
East edge block wall on lot line

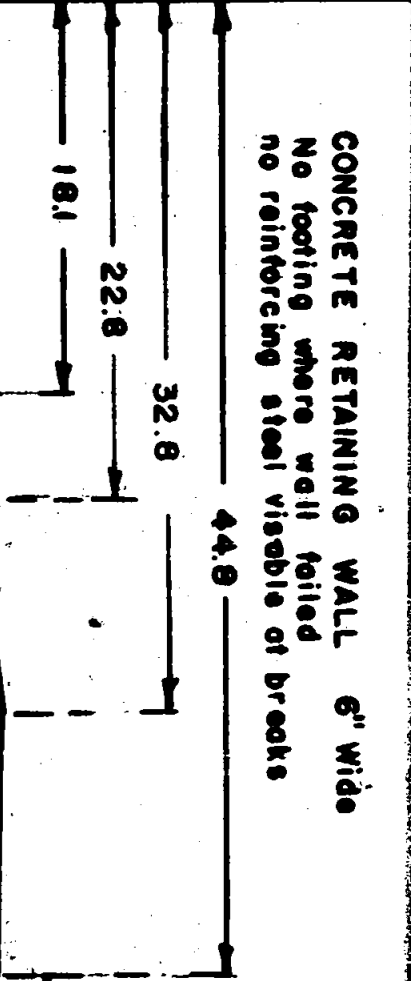

12

11

10

107.5

107.5

107.5

MR. DEAN WELCH

MR. HAROLD HEWLETT

5.701
BLOCK WALL 3 blocks high

East edge block wall on lot line

BLOCK WALL 4 blocks high

33.7

23'

OF THE
SCALE 1"

3/4" pipe found

70.0


1 1/4" pipe around original pipe

70.0

1 1/4" pipe around original pipe

70.0

End block wall 0.35' W & 0.15' S of cor.

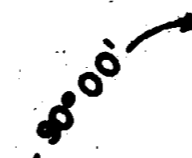

OREGON AVENUE