


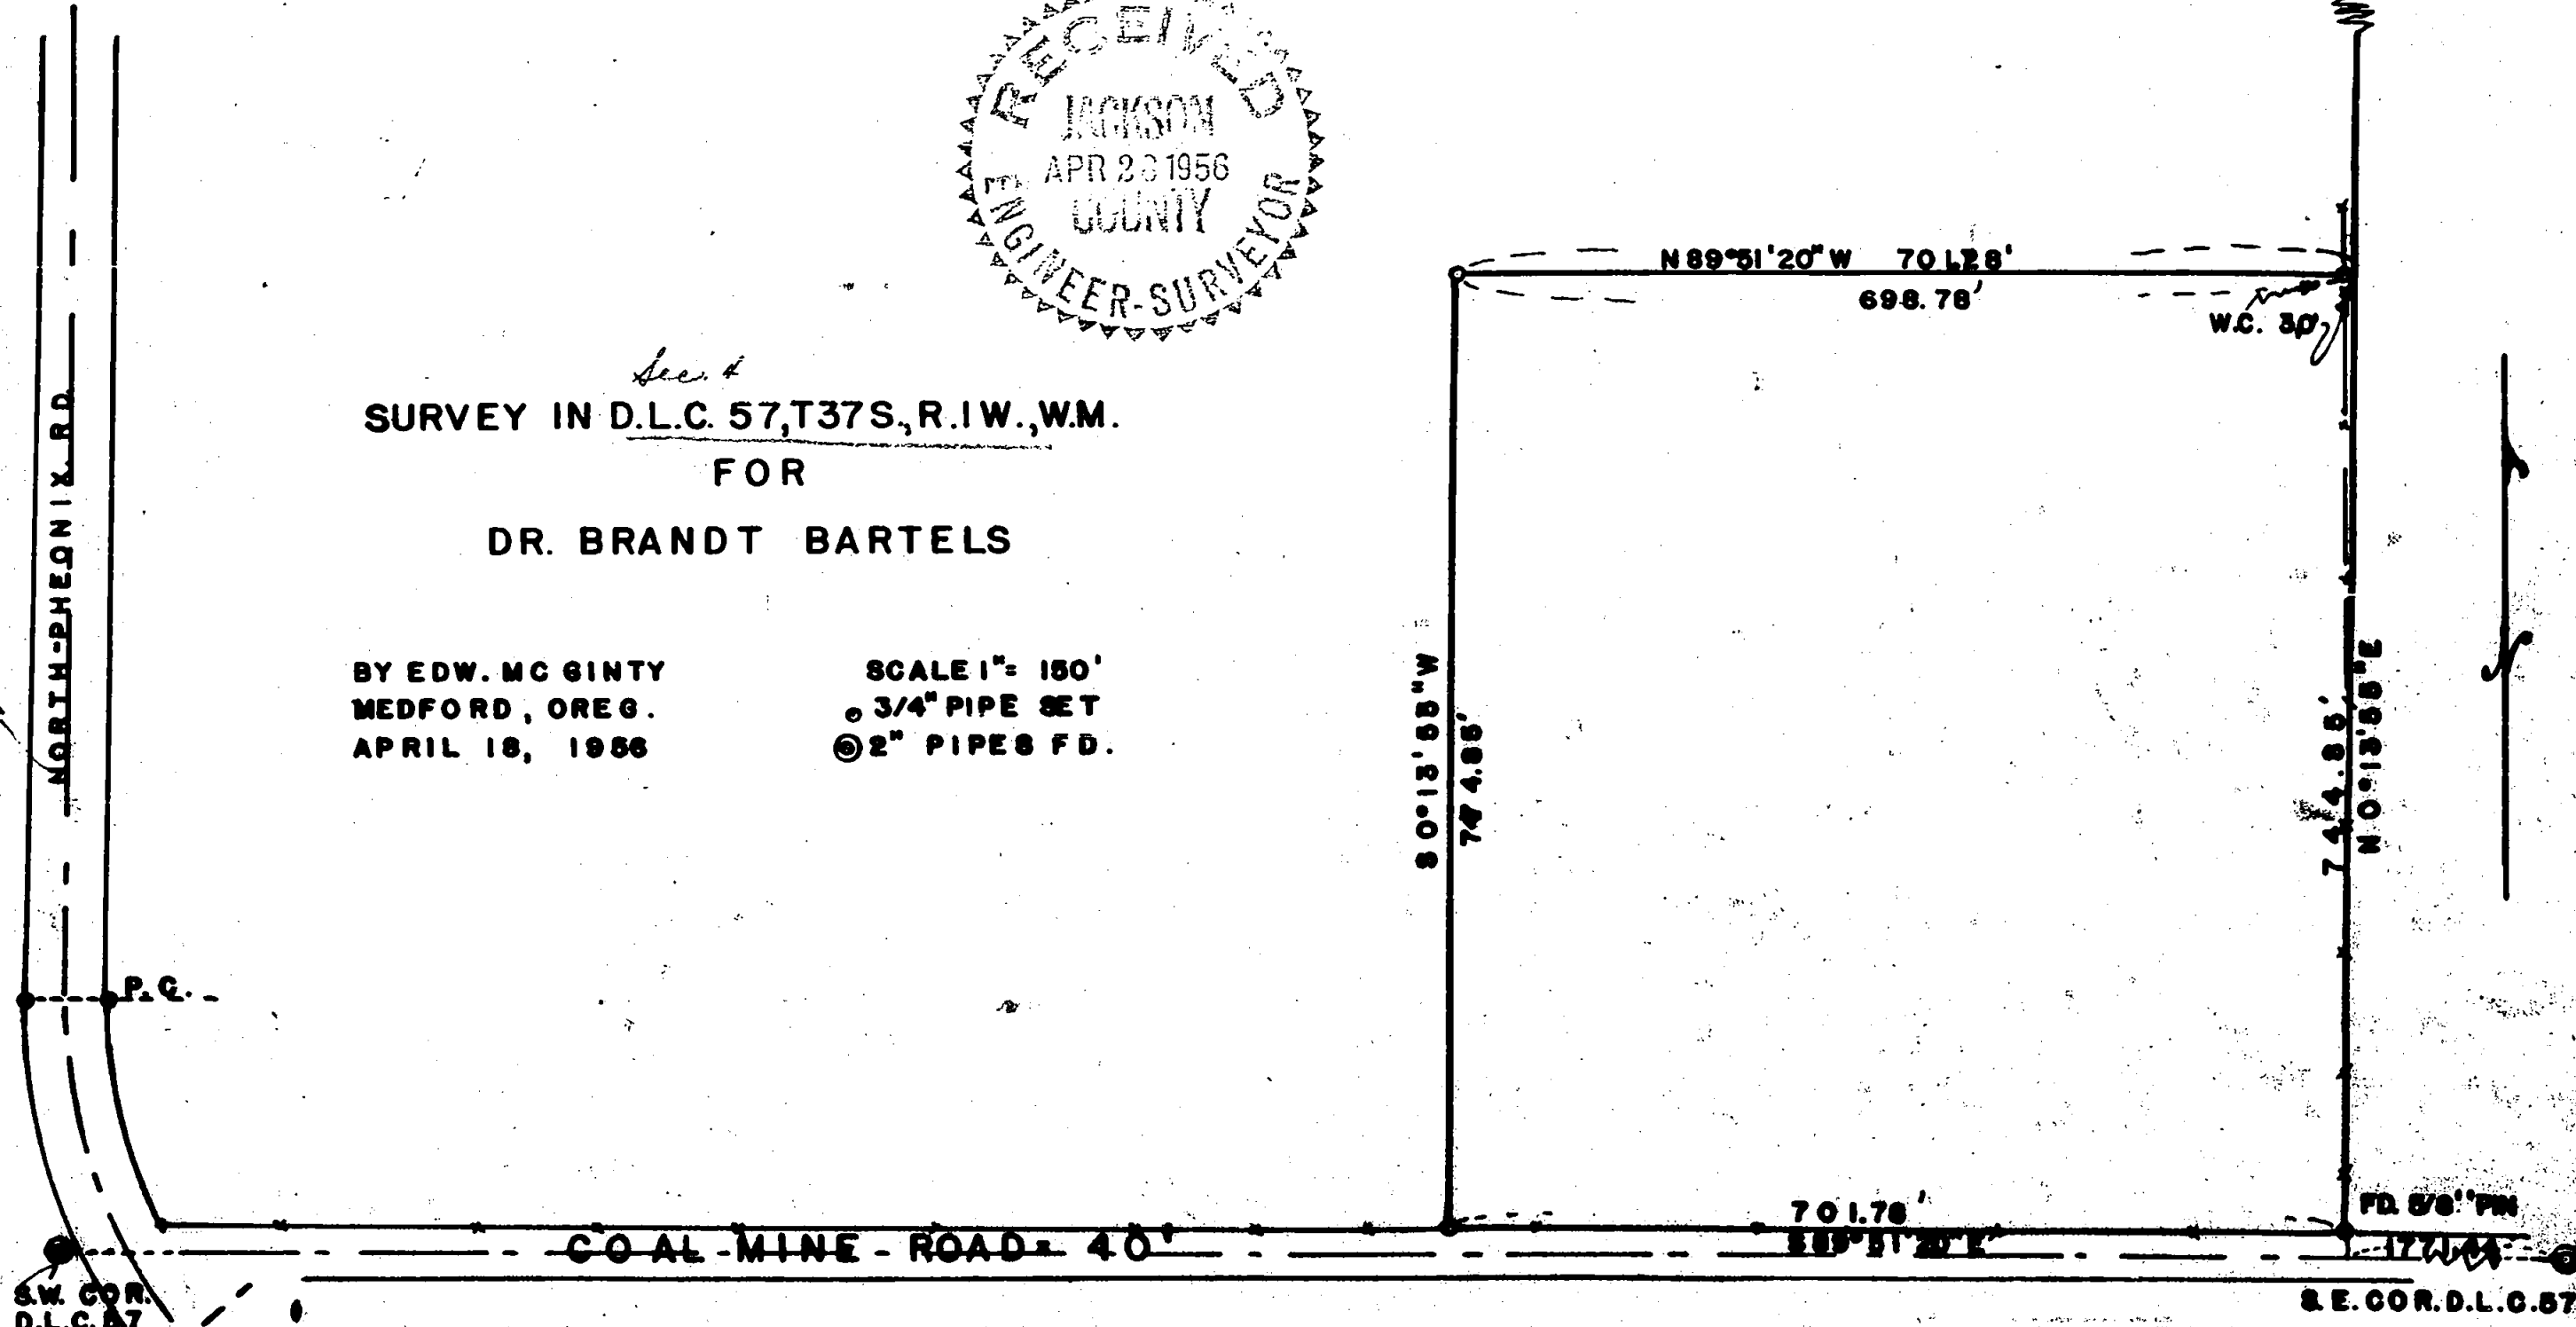

Sec. 4
 SURVEY IN D.L.C. 57, T37S., R.1W., W.M.
 FOR
 DR. BRANDT BARTELS

BY EDW. MCGINTY
 MEDFORD, OREG.
 APRIL 18, 1956

SCALE 1" = 150'
 3/4" PIPE SET
 2" PIPES FD.



Survey No. 810

Survey Narrative to comply with O.R.S. 209-205 and O.R.S. 209-120

Survey for: Dr. B. Brandt Bartels

By: Edward A. McGinty

BASIS OF MEASUREMENT:

Solar observation, previous survey

PRECEDENCE OF SURVEY:

Found corners of previous survey, on record in the County Engineers office.
The South line of B.L.C. 57 being the center line of a 40.00 foot County
road, commonly known as Coal Mine road, previously known as Griffis Road.
Tied in the SW and SE corners of B.L.C. ⁵⁷ as shown.



Edward A. McGinty
JULY 10, 1953
EDWARD A. MCGINTY
301