

818


813

JOHN GARNER  
LOT 5, BLK 1, WELLINGTON HEIGHTS ADD.  
TO CITY OF MEDFORD  
BOYDEN & BOYDEN NOV. 1955


20°21' SEC.  
29°28' COR.

99.25  
REC.

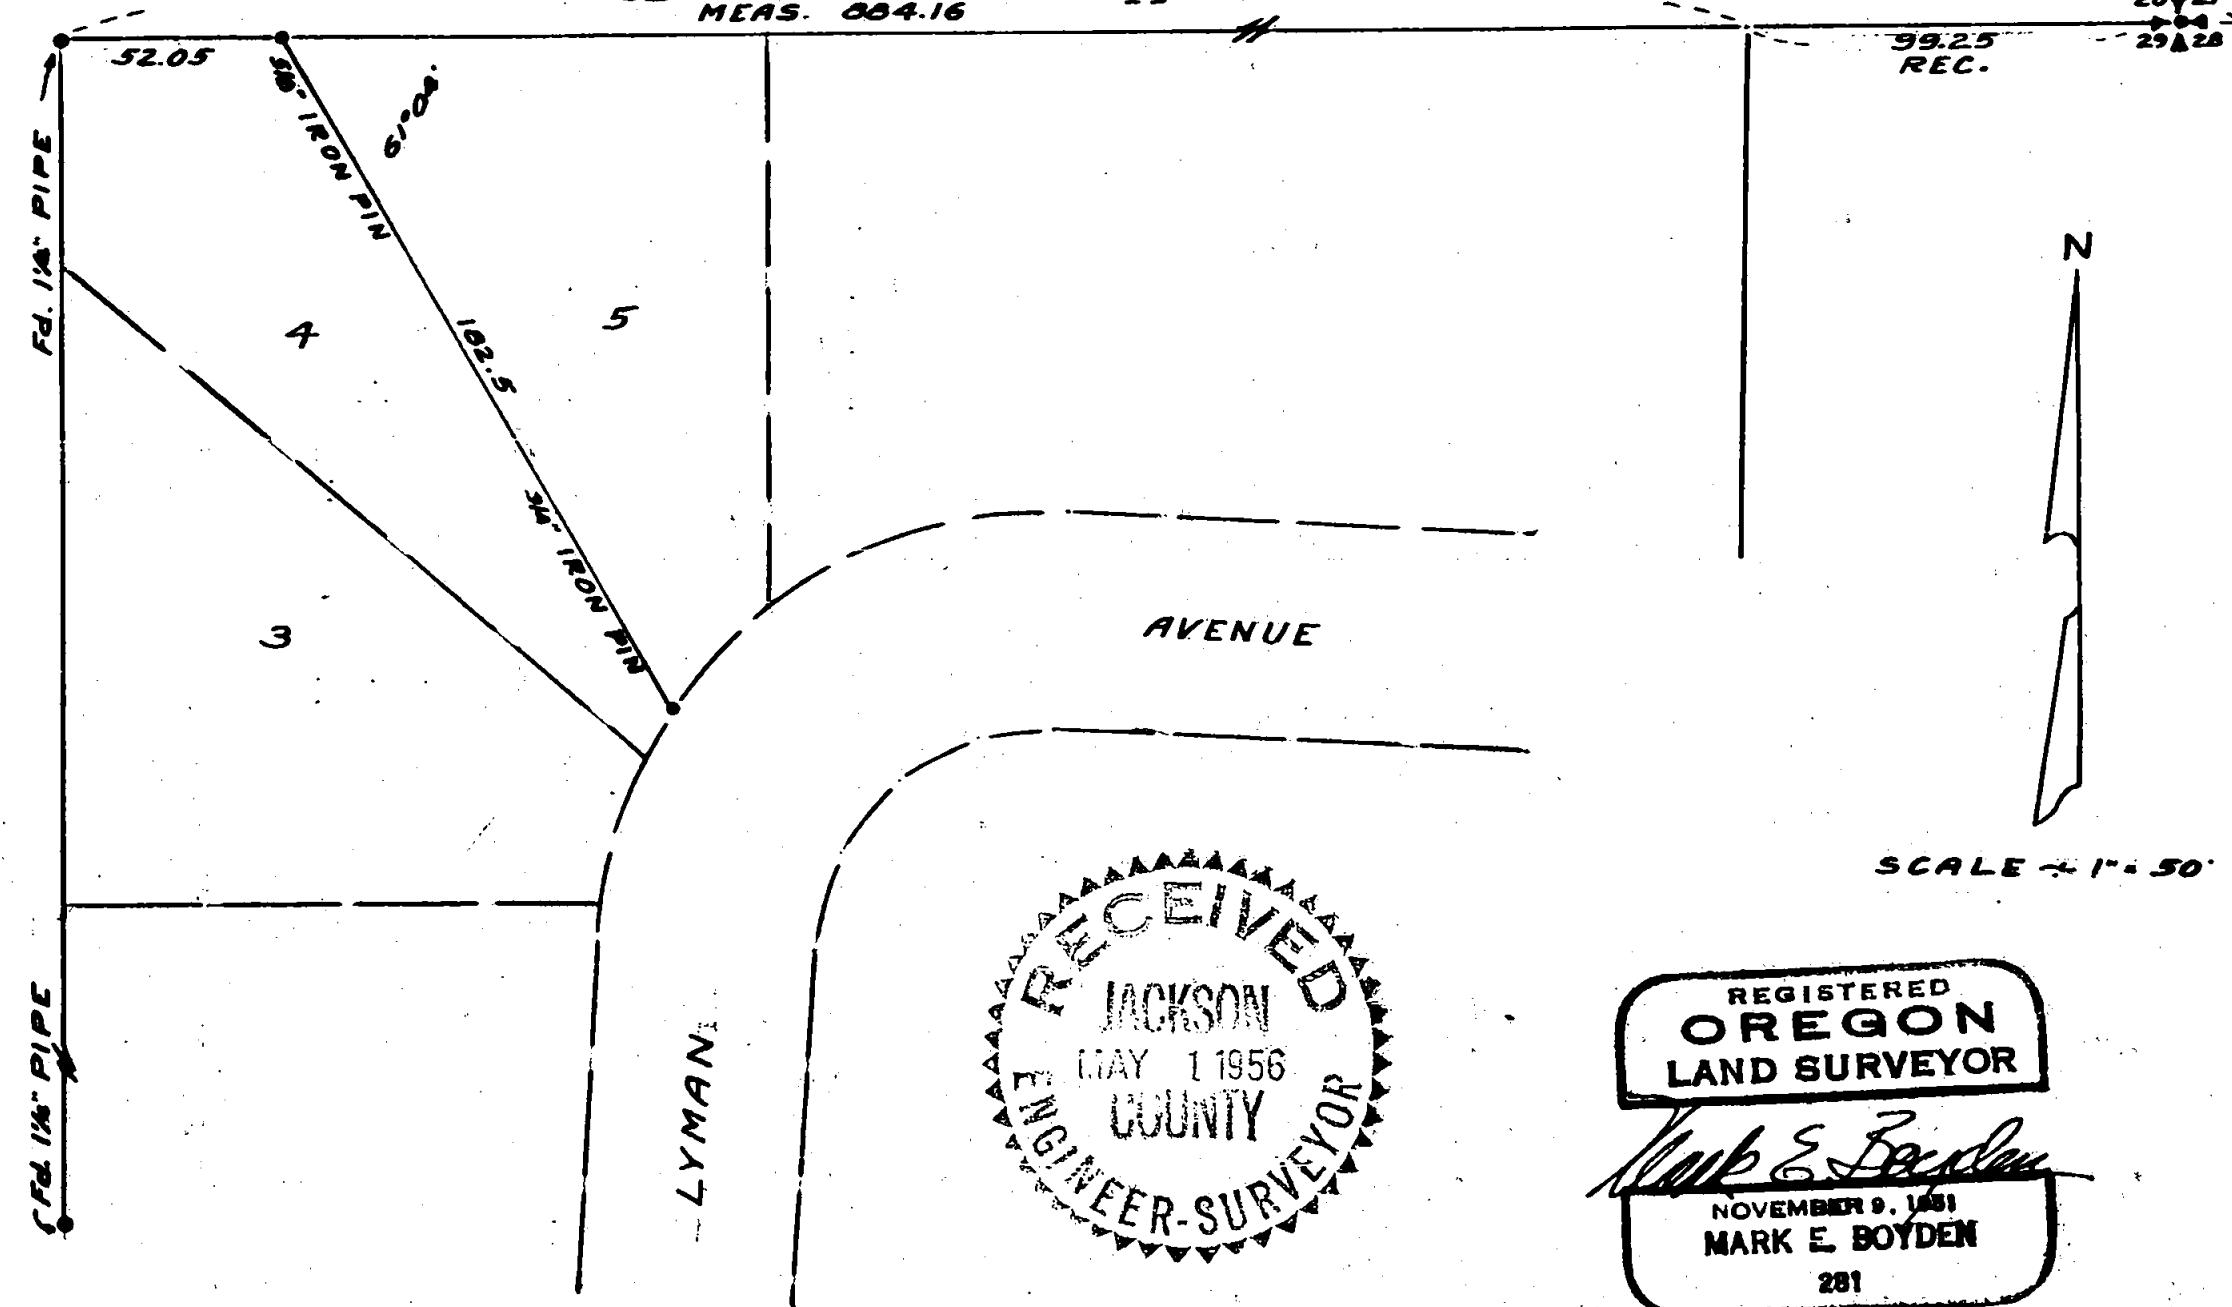

813

**Survey Narrative to comply with Paragraph 209.250,****Oregon Revised Statutes****FOR:** John Garner**PURPOSE:** To establish the Westerly line of Lot No. 5, Block No. 1,  
Wellington Heights Addition to Medford.**PROCEDURE:** Retraced the line between the Section corner and the  
 $1\frac{1}{4}$ " pipe found at the Northwest corner of said Addition. Since the  
Northeast corner of the Addition and the intermediate lot corners  
could not be found, the Northeast corner was considered to be  
99.25 (record distance) Westerly from the Section corner and on  
line with the  $1\frac{1}{4}$ " pipe found at the Northwest corner of the Addition,  
and the Northwest corner of said Lot 5 was set on a direct propor-  
tion between plat record and the measured distance along this  
North boundary.

No evidence of original monuments could be found for the  
location of Lyman Avenue and since the plat record location contains  
major errors, establishment by record is impracticable. Therefore,  
the Westerly line of said Lot was set at a record angle and distance  
from the North boundary. When a location of Lyman Avenue is estab-  
lished by duly constituted authority, this, the most Southerly  
corner of Lot 5 may be subject to change.

November 1955

