


KENNETH LACY  
IN BLK. NO. 71, ORIG. TOWN  
CENTRAL POINT ORE.  
M.E. BOYDEN MAY. 1956

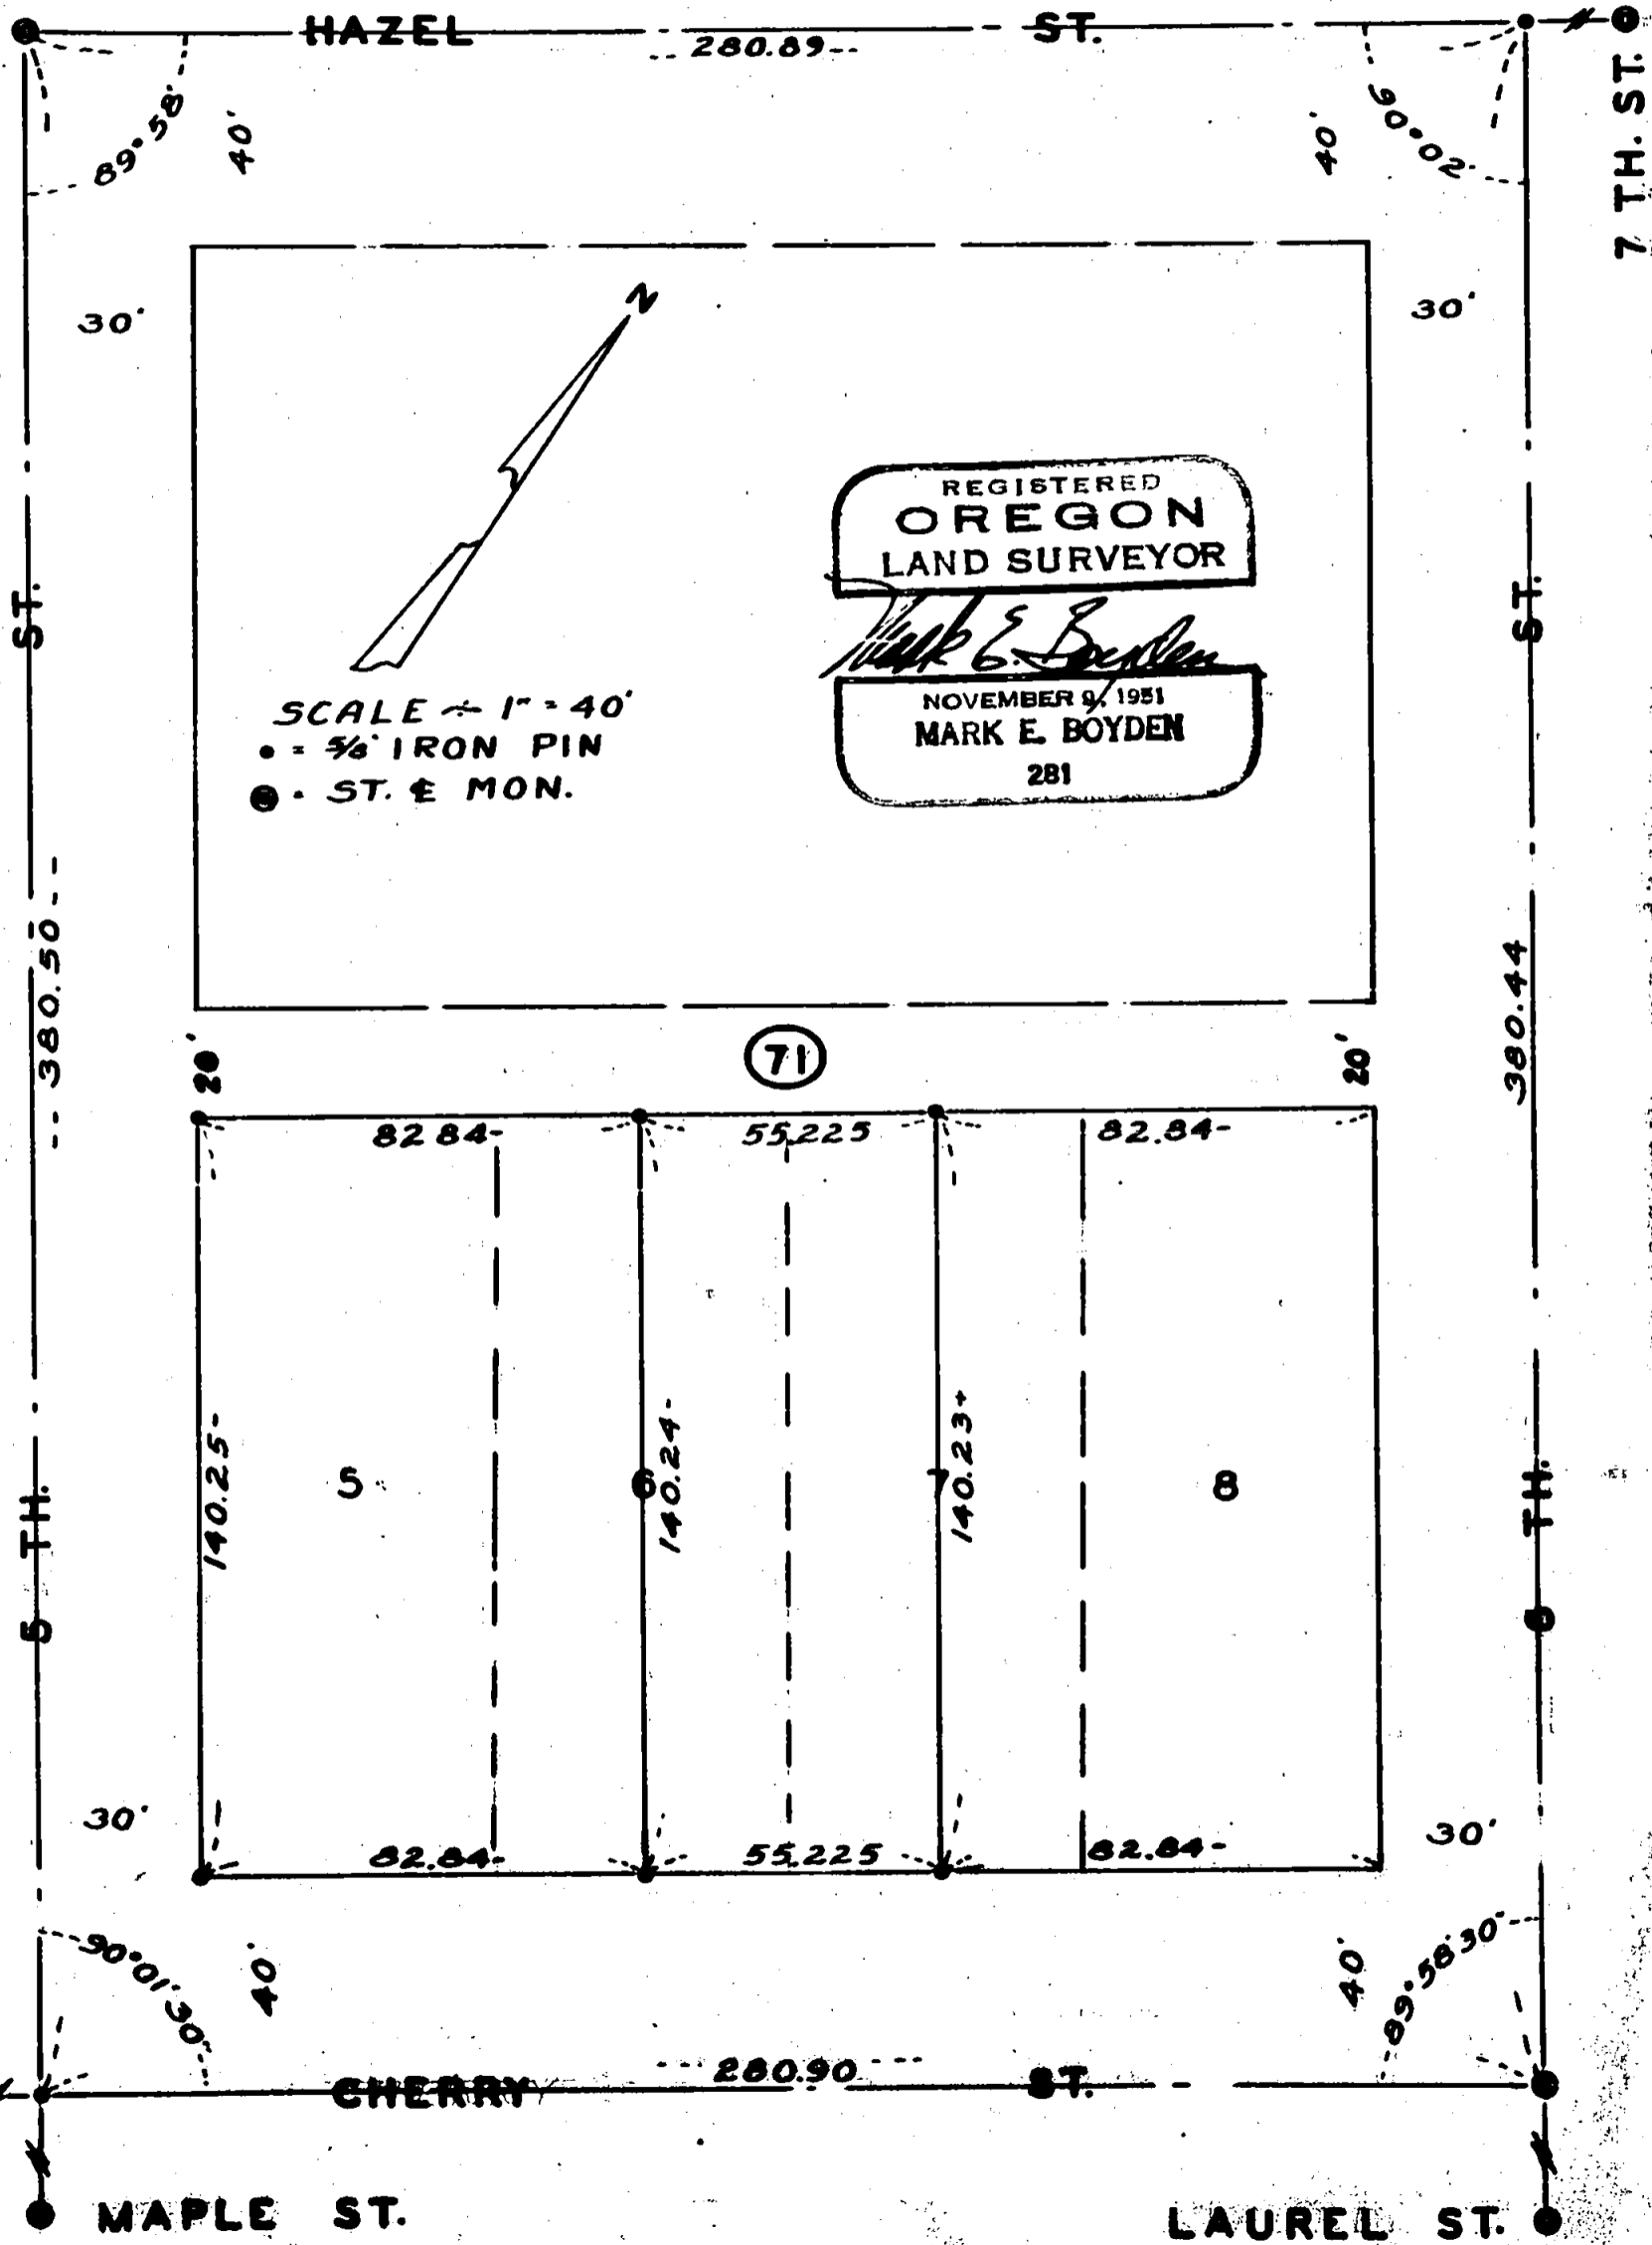

Survey Narrative to comply with Paragraph 209.250,  
Oregon Revised Statutes

FOR: Kenneth Lacy

PURPOSE: To survey the Lacy property being the Easterly 1/2 of Lot No. 6 and the Westerly 1/2 of Lot No. 7 of Block No. 71 of the Original Town (now City) of Central Point; also to set the Westerly and Southerly corners of Lot No. 5 of said Block.

PROCEDURE: Established the street centerlines of the streets enclosing said Block No. 71, by using the concrete monuments with center point set at alternate intersections as indicated. The two street intersections at the Northerly and Southerly corners of said Block were established by intersecting the lines between the nearest monuments to said intersections. These lines enclosing said block were then measured and the required property boundaries were set by proportioning between record and measured distances. Monuments were set as indicated on the map to accompany this report.

May 1956

