

Sec 19 $\text{Fd } \frac{1}{4} \text{ Cor.}$ Sec 20 $\text{N}89^{\circ}51'30''\text{W}$ $\text{Rc} = \text{N}89^{\circ}53'15''\text{W}$
 670.08 $\text{Rc} = 669.50$

SPRING ST.

BLK 10

$\text{Rc } 989^{\circ}53' \text{ E}$
 $\text{S } 89^{\circ}51'30'' \text{ E}$

LAWN RIDGE ST.

$\text{Rc } 299.75$
 299.86

51.86	50.00	"	"	50.00	48.00
131.375	596.151	5	4	3	2
50.80	50.00	" Blk 11			49.00
131.375	596.151	7	8	9	10
49.74	50.00	"	"	50.00	50.00
131.375	596.151	11	12		

$\text{Rc } 299.74$
 $\text{Rc } 299.75$
HILLCOURT ST.


$\text{N}89^{\circ}51'30''\text{W}$
 $\text{Rc } \text{N}89^{\circ}53'15''\text{W}$

BLK 14

RIDGEWAY

Basis Of Bearing East Wood Subd. Rev.

$\text{N}89^{\circ}59' \text{ W}$ 669.86 $\text{Fd } 1/4 \text{ Cor.}$
North Line of East Wood Subdivision

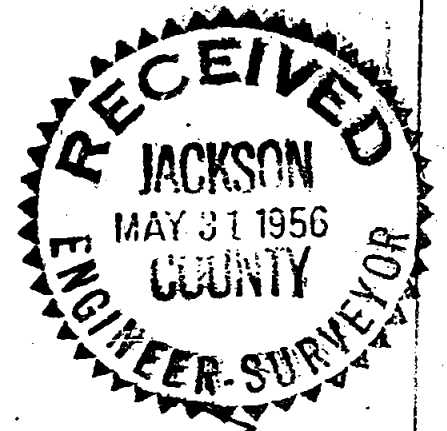

OREGON LAND SURVEYOR
Leland P. Lovejoy
NOVEMBER 18 1953
LELAND P. LOVEJOY
282

RESURVEY BLK 11
COLLEGE HILL ADD. TO MEDFORD
TWP. 37S RGE. 1W
FOR FRANKLIN JONES
Medford Oregon
By L. Lovejoy
Scale 1" = 100'
April 17, 1953
Rev 11-14-55

Survey Narrative To Comply With Section 87-330;**State of Oregon Law 1947**

Survey For: Franklin Jones
Medford, Oregon

Purpose of Survey: Resurvey of Block 11,
College Hill, Addition

Survey Location: City of Medford, Oregon.

Survey Procedure: Found monuments and corners as shown on map.
Set 3/4" steel pins at lot corners.

Leland P. Lovejoy
Registered Land Surveyor

