

NOTE:
 CORNER & B.T.s DESTROYED BY ROAD CONSTRUCTION
 SET 1" G.I.P. FOR W.C. TO 1/4 COR. ON NORTH EDGE ROAD
 PIPE BEARS N.0°06'40" W. 19.50' FROM 1/4 COR. POSITION
 FOLLOWING TREES REFERENCED FROM PIPE
 6" LAUREL S.32° E. 19.71'
 6" FIR N.38 1/2° W. 9.26'
 7" FIR N.21° E. 13.35'

BEARINGS DETERMINED BY SOLAR OBSERVATION
 GURLEY TRANSIT USED, EXTREME ROUGH COUNTRY
 TRAVERSE CLOSURE: 2680, CHAINING NOT CORRECTED FOR
 TEMPERATURE.

OREGON
 LAND SURVEYOR
Leland P. Lovejoy
 LELAND P. LOVEJOY
 258

RECEIVED
 JACKSON
 MAY 31 1956
 COUNTY
 ENGINEER-SURVEYOR

MAP SHOWING SUBDIVISION
 OF
 SEC. 9, T.32S., R.2E., W.M.
 JACKSON COUNTY, OREGON
 FOR
 ELK LUMBER Co. and ROBT. VON DER HELLEN
 L.P. LOVEJOY L.S. MISSOURI, ORE.
 SCALE: 1" = 500' JULY 18, 1955

Survey Narrative To Comply With Section 87-330

State of Oregon Law 1947


Survey For: Elk Lumber Company, Medford, Oregon, and Robert von der Hellen, Eagle Point, Oregon

Purpose of Survey: Run out property boundaries.

Survey Location: Section 9, Township 32 South, Range 2 East, Willamette Meridian, Jackson County, Oregon.

Survey Procedure: Found corners as shown on map. Set corners as indicated on map.

Leland P. Lovejoy
Registered Land Surveyor
Work not completed to date, May 31, 1956,
pending decision of Elk Lumber Company
to set additional 1/16 corners.

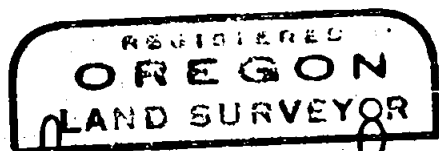

Leland P. Lovejoy

