


5 6
7 8
COKER BUTTE RD.

1/4 COR.

D.R. 336-444

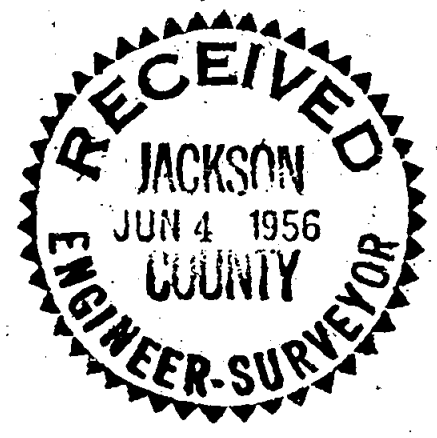

(REC. 726.0') P.P. 726.38'

90'00"
PROPOSED PROP. LINE
900.03

(REC. 264.0')
P.P. 264.87'

27.0'

D.R. 360-283

3/16 COR.

SURVEY W. LINE SEC 8 T.37S.R.1W. W.M.
FOR
J. CUMMINGS

BY EDW. MC GINTY
MEDFORD, OREG.
MAY 26, 1956

SCALE 1"=200
O-SET 5/8" PINS
C-COR. FOUND.

REGISTERED
OREGON
LAND SURVEYOR

Edward A. McGinty

JULY 10, 1953
EDWARD A. MCGINTY
301

7 8
18 17
DELTA WATERS RD.

Survey Narrative to comply with O.R.S. 209-205 and O.R.S. 209-120

Survey for: Jack Cummings


By: Edward A. McGinty

Sec. 8, T137 S, R. 1 W.

PRECEDENCE OF SURVEY

Found southwest corner of Section 8 also the northwest corner of said section, said northwest corner being recently re-established, more commonly known as the point of beginning on the center line of Coker Butte Rd. but accepted as best evidence being near or at said section corner.

Set points along said section line as shown. Re-establishing west 1/4 corner at proportional distance also South 1/16 corner at proportional distance.

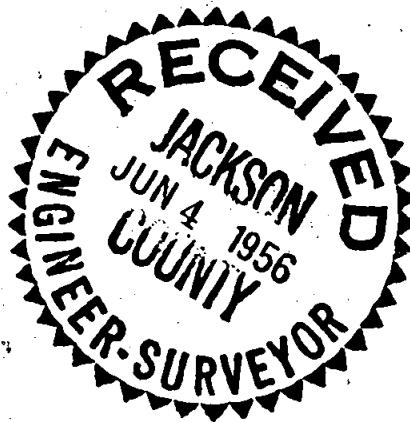

Edward A. McGinty

