

Edward A. McGinty, L.S.
166 King Street
Medford, Oregon

June 4, 1956

Paul Rynning, County Surveyor
Jackson County Court House
Medford, Oregon

Subject: Re-established Section Corner

Township 38 South, Range 2 West


²³
1/4 corner 24 and 25

Set semi quartz stone 10" X 6" X 6", from which orig. Black Oak, now
18", only the BT visible, also BT visible on over growth, bears
South 25° West 33 lbs.

Orig. Black Oak North 42° East 33 lbs.

Double blazed 6" fir bears South 52° East 9 lbs.

Center of County road bears North approx. 18.00 chains.

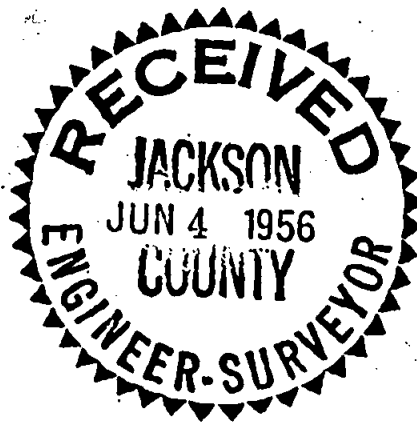

Edward A. McGinty

