

**SURVEY OF LOT 3 BLOCK 5 FAIRMOUNT ADD.
IN CITY OF MEDFORD, JACKSON COUNTY, OREGON.
FOR MARVIN TRAUTMAN.
April 21, 1956 Scale 1"=100'**

258
857

JACKSON ST.

1/4 Sec. Cor.
Mon. found

Mon

REGISTERED
OREGON
LAND SURVEYOR
L. N. Dow
MAY 6, 1949
L. N. DOW
251

ADDITION

ST

ST

Con. Mon.

HAVEN ST

Con. Mon.

90°24'12"

SUMMIT

FAIRMOUNT

RECEIVED
JACKSON
JUN 13 1956
COUNTY
ENGINEER-SURVEYOR

OAK

Street ctr. nail
not yet monumented

FAIRMOUNT ST

Record 562.98

P/P 403.50

30' 30'

90°24'12"

126.34 52.95 105.97

90°18'

126.34
52.95

Con. Mon.

SECOND ST

Con. Mon. N.W. Cor.

Consolidated
Add. No. 4

857


Written narrative to accompany plat for survey No. _____

Survey for Marvin Trautman, Medford, Oregon.

Date of Survey April 21, 1956.

Purpose to stake Lot 3 Block 5 Fairmount Addition, Medford, Oregon.

Procedure, having previously ran the east line of the subdivision between the 1/4 section corner on Jackson Street and the concrete Monument at the Northwest corner of Consolidated Addition No. 4, I then turned the angle from the concrete monument at the center of Summit street and Haven Street to the monument at Haven and Oak Street, We then checked out the center nail at the center of Summit and Fairmount Street. We next chained the distance to the east line of Fairmount Addition and found that by the proportional distances the 53 foot lots become 52.95 feet; we then staked the lot with 5/8 inch pins as shown on the plat.

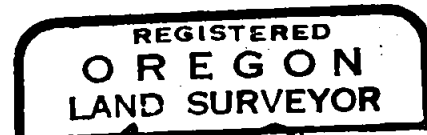

L. N. Dow.

