

268

268

268


Survey of Lot 20 Block 13 Laurelhurst Addition, Medford, Oregon.
 For Mr. Wm. H. Alger, 419 Pearl St. Aug. 19, 1956 Scale 1" = 200'

5/8" Round bars set at corners Lot 13.
 Angles indicated were turned.


REGISTERED
 OREGON
 LAND SURVEYOR

L. N. Dow

MAY 6, 1948
 L. N. DOW
 251

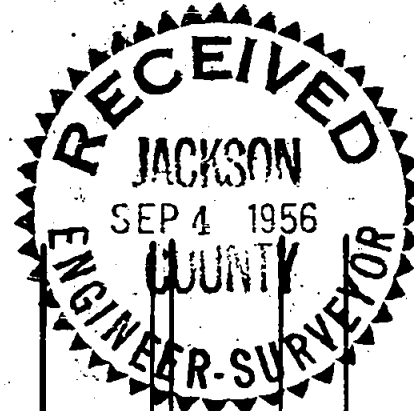

Mon N.E. Cor. D.L.C. 42

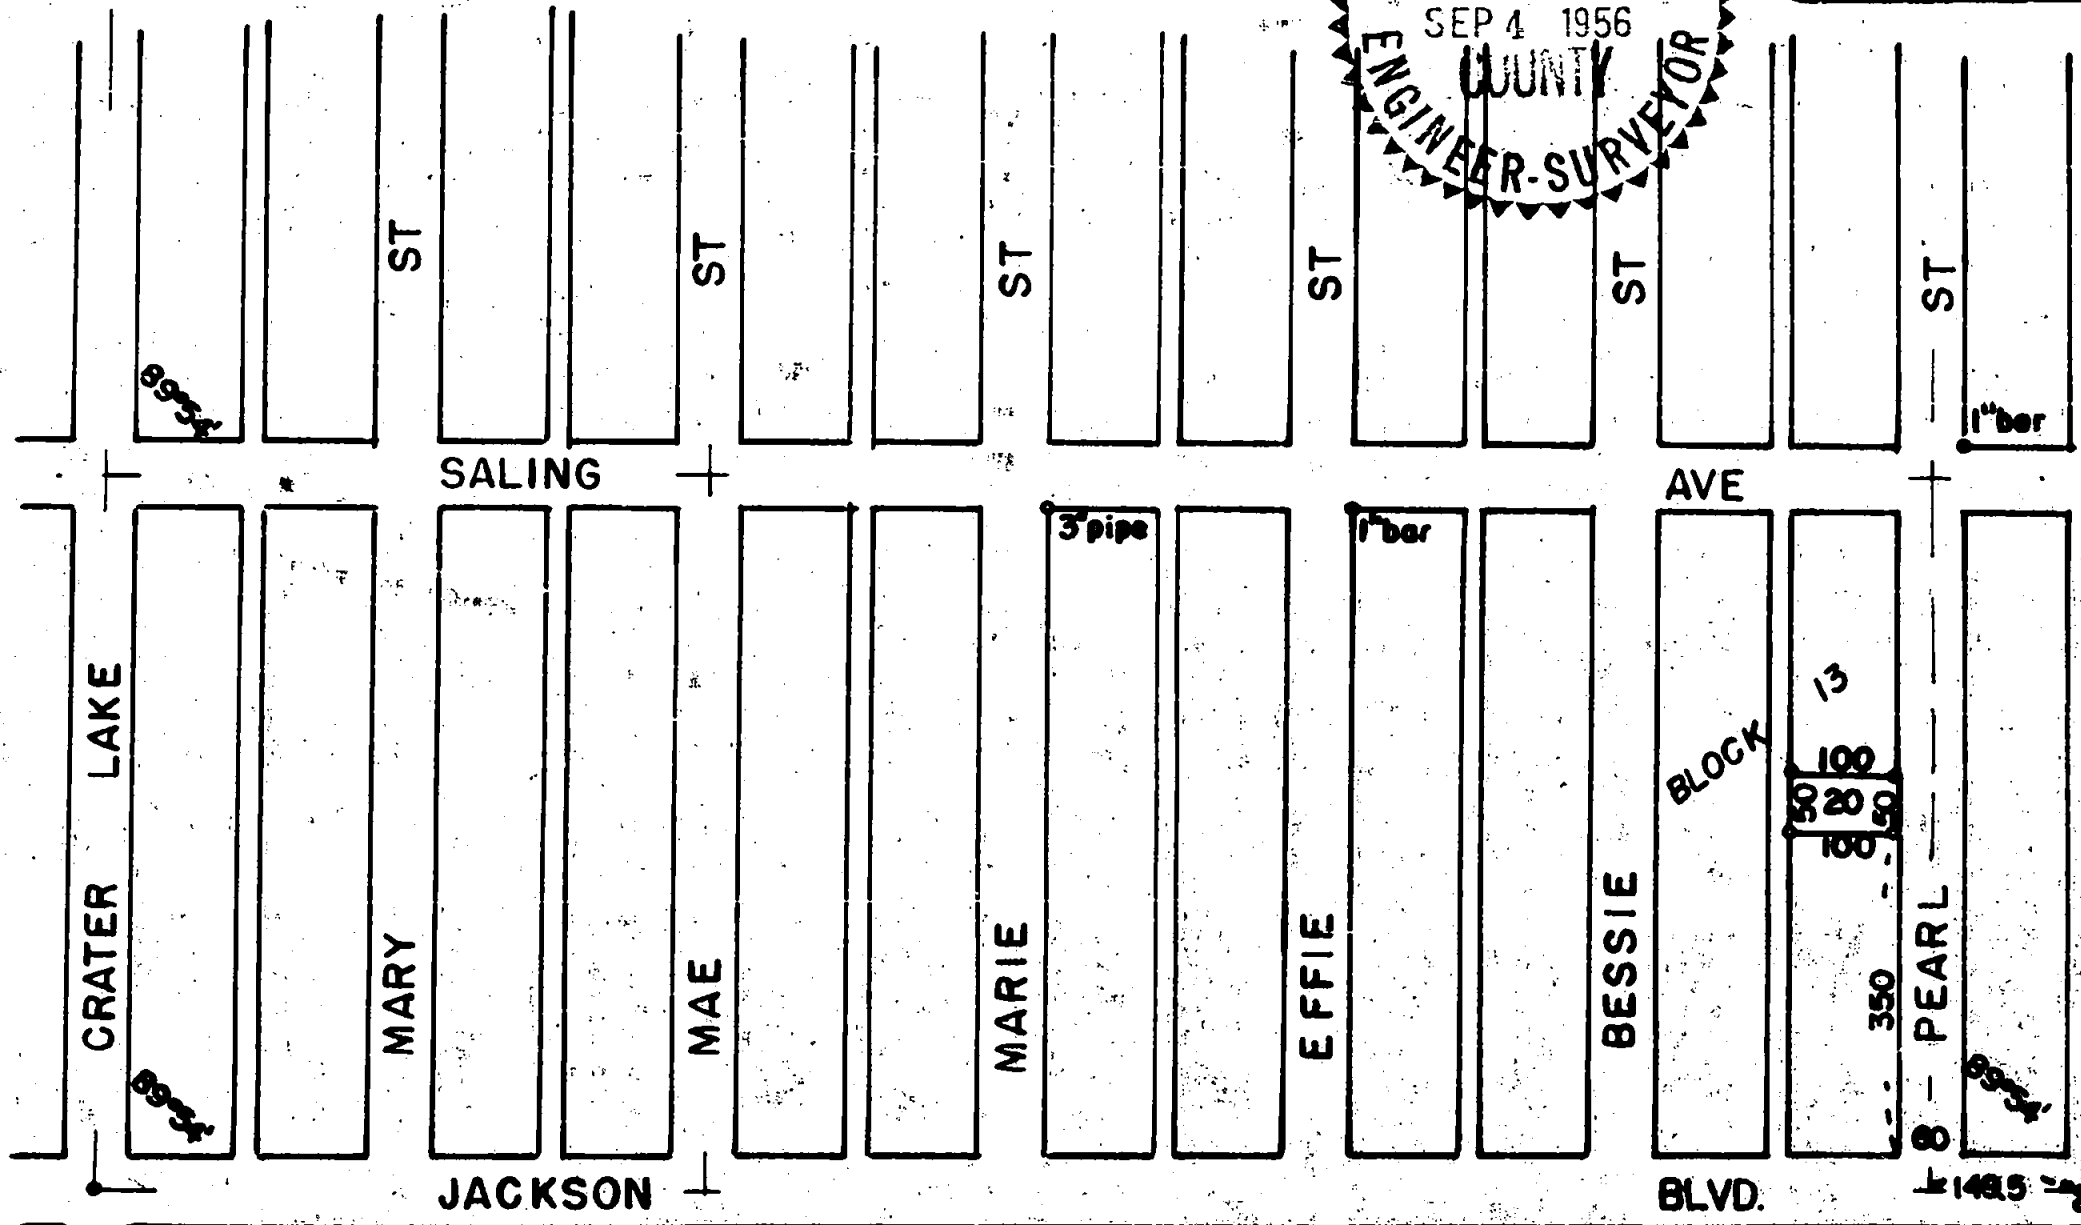

Conc. Mon

149.5 ± 10'

Conc mon

Sec. Cor. 19 20
 30 29



Written narrative to accompany plat for survey No. 892

Survey for Mr. Wm. H. Alger, 419 Pearl St, Medford, Oregon.

Location Lot 20 Block 13 Laurelhurst Addition to the City of Medford, Jackson County, Oregon.

Date August 19, 1956.

Procedure; From a previous survey having located and turned the angles from the monuments shown on this plat, we re-occupied the monument at the section corner for sections 19, 20, 30 & 29 and set the center of Pearl and Jackson Street at a point 10 feet north and 149.5 feet west of the section corner.

Then using the iron bar at the northeast corner of Saling and Pearl we rechecked for angle previously used.

We then ran north on Pearl and set the corners for Lot 20 using 5/8 inch iron bars for all corners as shown.

