


FOOTS CREEK Co. Rd.

Note: Curve Data.
 A = 27° 43'
 C = 236.08
 R = 492.77

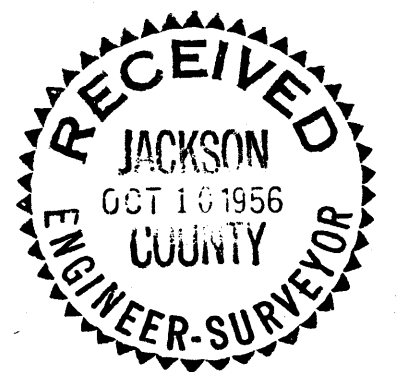

PLAT OF LAND

SITUATE IN NW 1/4 SEC 2, T37S, R4W, W.M.
 JACKSON COUNTY, OREGON
 Scale 1" = 40' July 12, 1956 Drawn By F.L.B.

REGISTERED
 OREGON
 LAND SURVEYOR


Fredrick E. Warner

NOV 7 1952
 FREDRICK E. WARNER
 298

908

NARRATIVE: Survey of tract of land for Mr Glen DeJanvier, July 1956.

Commencing at the true North $1/4$ corner of sec 2, T 37 S, R 4 W, W.M., Jackson County, Oregon, said corner being a $3/4$ " galvanized iron pipe, re-established by the county surveyor, I run West 5.75 feet and South 614.91 feet and set a $3/4$ " iron pipe. Then I run S $7^{\circ}49'$ W 163.00 feet and set a $3/4$ " iron pipe. Then I run 238.38 feet on the arc of a curve and set a $3/4$ " iron pipe. Then I run S $89^{\circ}54''$ W 318.38 feet and set a $3/4$ " iron pipe. Then I return to the first point set and I run S $89^{\circ}54''$ W 442.79 feet and set a $3/4$ " iron pipe.

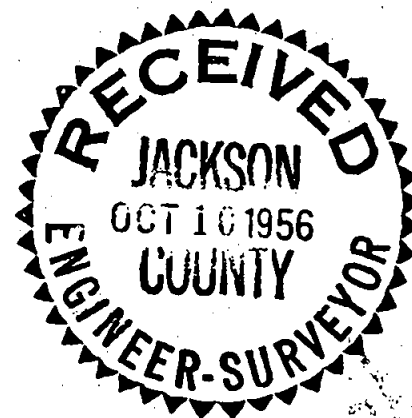

Fredrick E. Warner, Surveyor