



716
914

SURVEY FOR GENE CARRIGAN

CENTRAL POINT, ORE.
JUNE 1952

6"x6"x24"
Conc. Mon.

NW cor.
DLC #56
T37SR2W

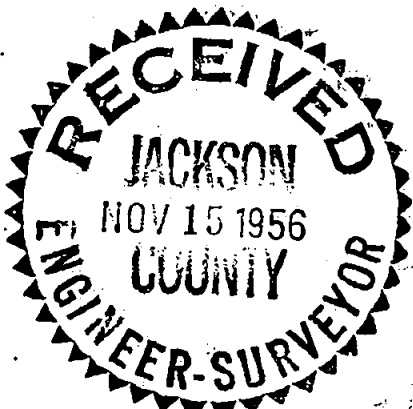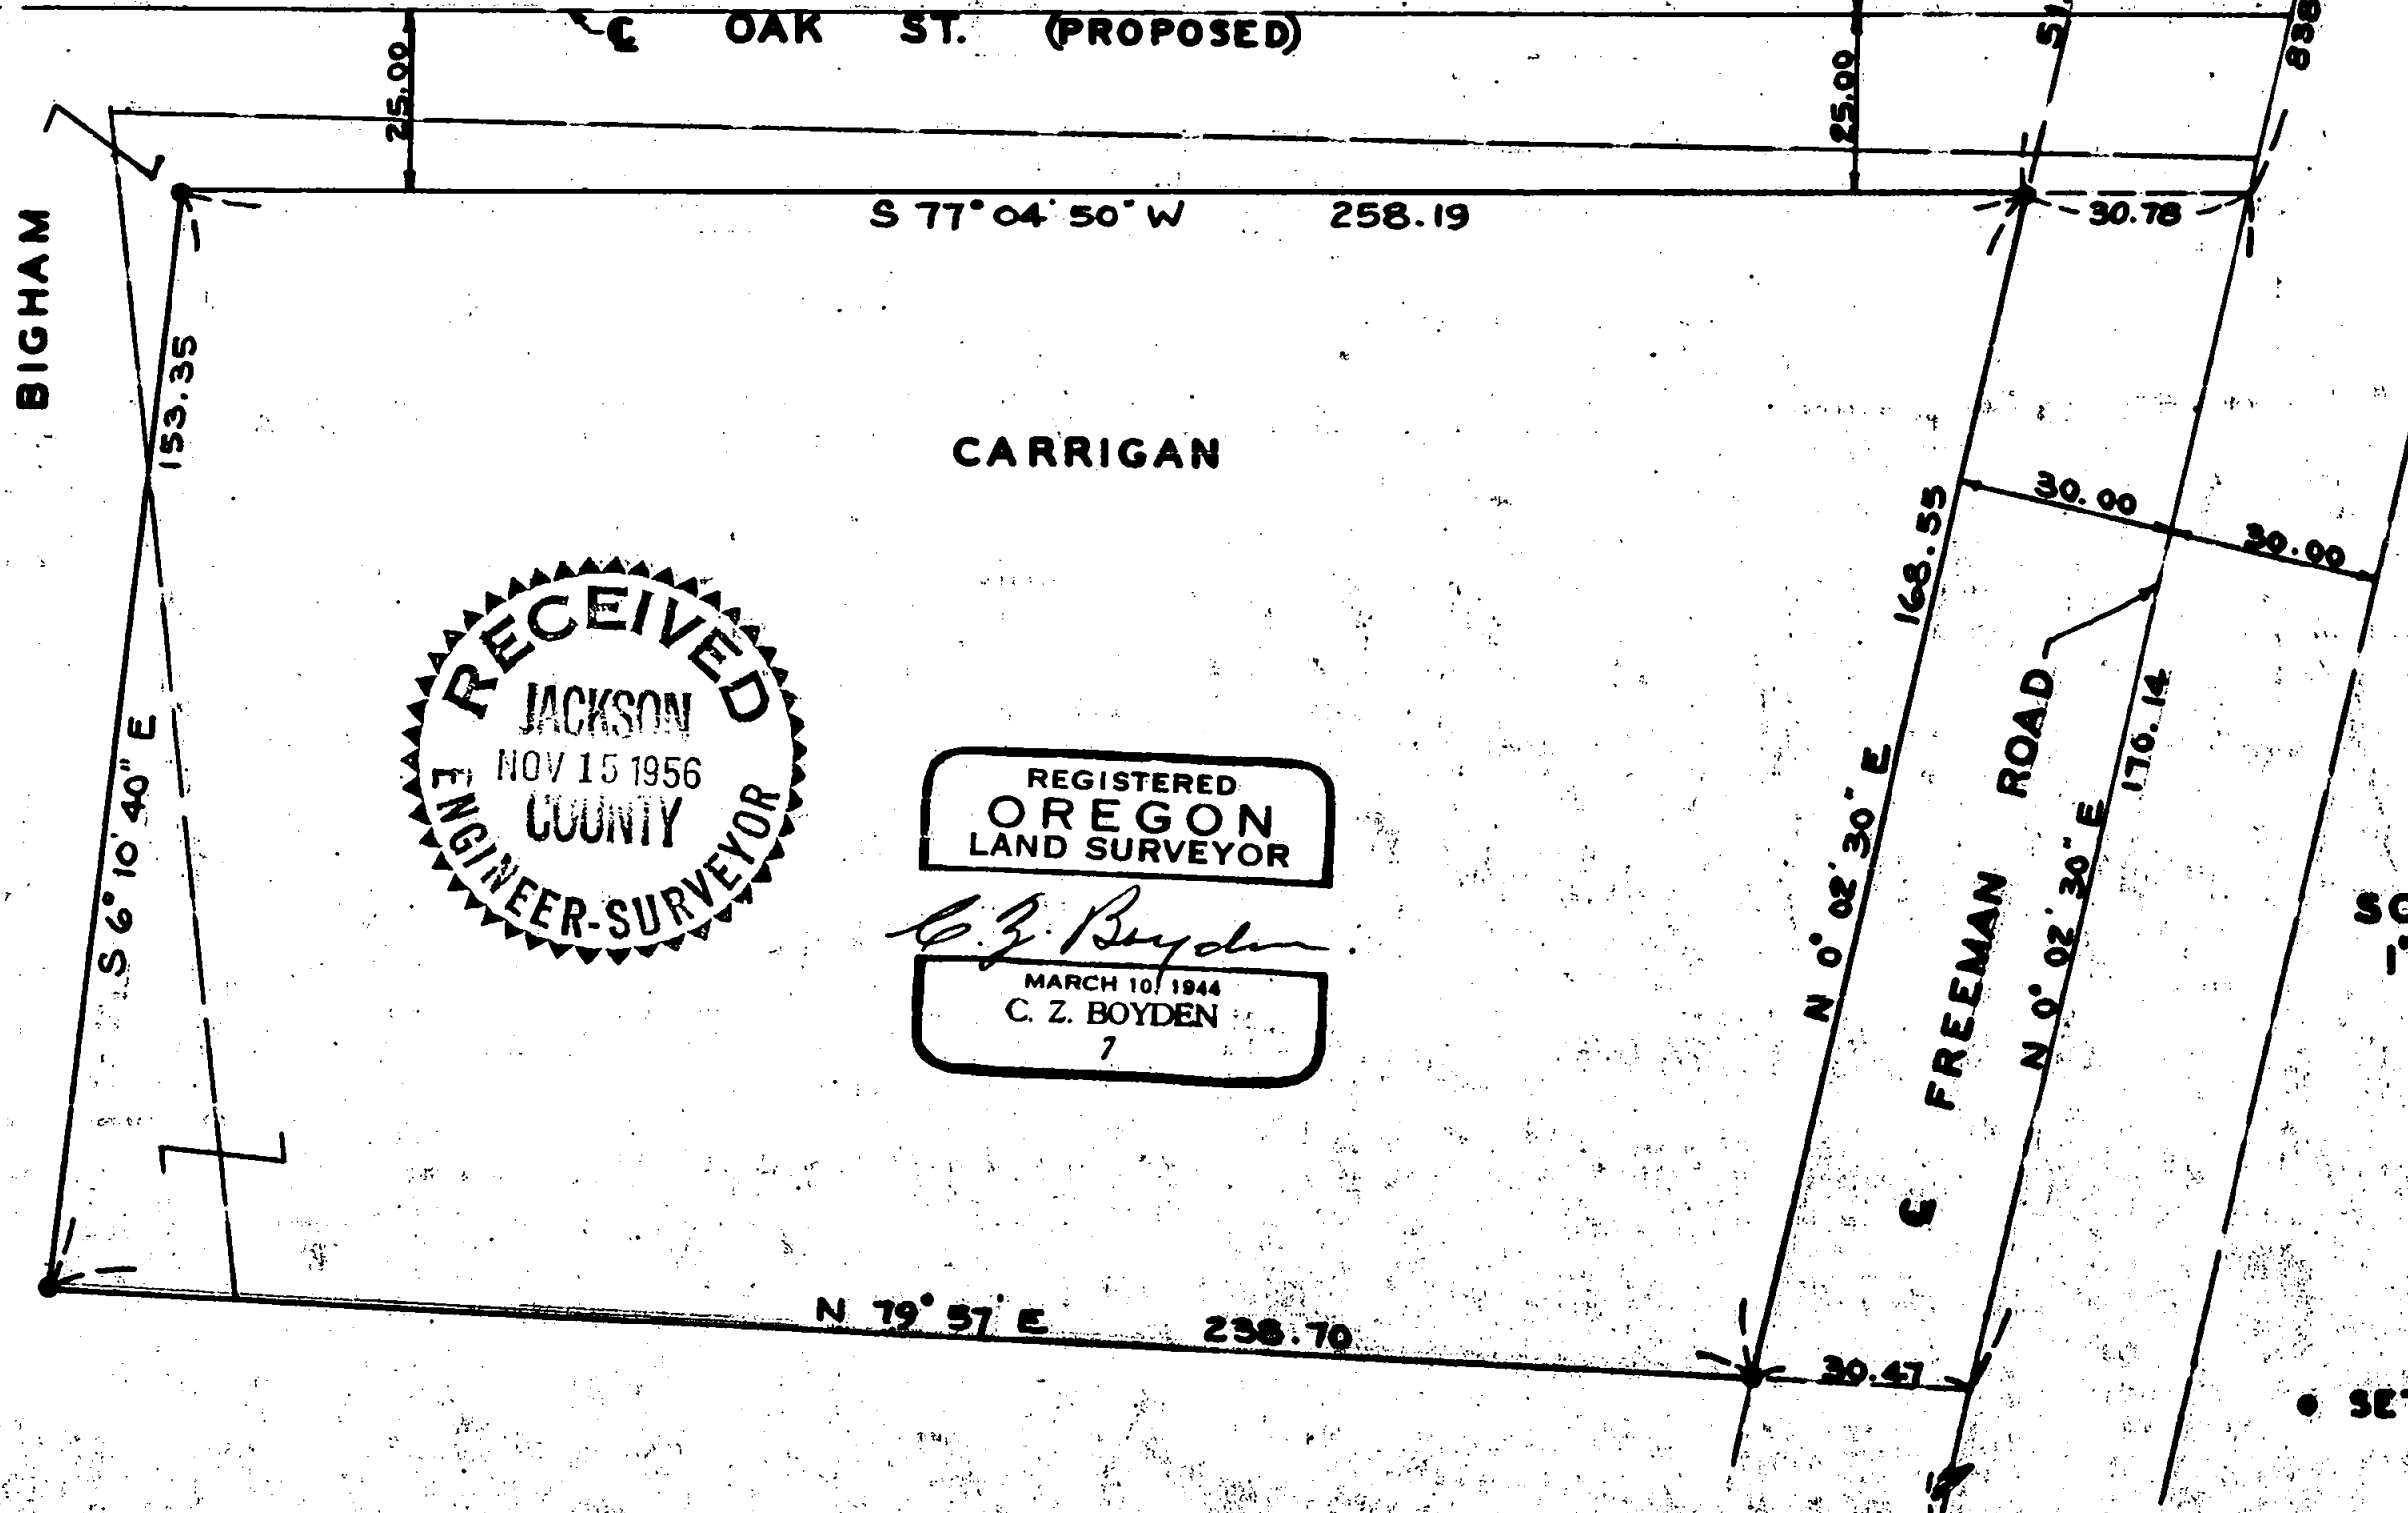

REGISTERED
OREGON
LAND SURVEYOR

C. Z. Boyden

MARCH 10, 1944
C. Z. BOYDEN
7

SCALE:
1" = 30'

• SET IRON PIN

SW cor. DLC #6

914

Survey Narrative to comply with Paragraph 209.250,
Oregon Revised Statutes

SURVEY FOR: Gene Carrigan

PURPOSE: To monument the new boundaries of the Carrigan property after the exchange with Bigham.

PROCEDURE: This survey was made in conjunction with the surveying for OAK KNOLL SUBDIVISION in the City of Central Point. The North and West boundaries were established by agreement and deed exchange between Carrigan and Bigham; the South boundary according to the corrected South boundary of the Carrigan property described in Jackson County Deed Records, Volume 258, Page 572.

Monumented the tract with iron pins as shown on the attached map with the meridian control being that of Oak Knoll Subdivision.

June 1952

REGISTERED
OREGON
LAND SURVEYOR

C. Z. Boyden

MARCH 10/1944
C. Z. BOYDEN
7

RECEIVED
JACKSON
NOV 15 1956
COUNTY
ENGINEER-SURVEYOR