

• 3/4" G.I. PIPE SET.

BEARINGS BASED ON PREVIOUS SURVEYS

Leland P. Lovejoy

**BOUNDARY LOCATION**

PROPERTY SITUATE IN

N.W. 1/4 SEC. 19, T. 36 S., R. 3 W., M.M.

JACKSON COUNTY, OREGON

LELAND P. LOVEJOY L.S. MEDFORD, ORE.

SCALE: 1" = 200'

DEC. 5, 1956

Survey Narrative to Comply With  
Section 87-330 of 1947 Oregon State Laws


**Survey for:** John R. Jore  
Bennett Avenue  
Medford, Oregon

**Purpose of Survey:** Run out property boundaries.

**Survey Location:** Northwest Quarter of Section 19,  
Township 36 South, Range 3 West,  
Willamette Meridian, Jackson  
County, Oregon.

**Survey Procedure:** Found corners as shown. Run out property  
boundaries and set 3/4" galvanized iron  
pipe as shown on map.

Leland P. Lovejoy  
Registered Land Surveyor  
Work completed December 19, 1956

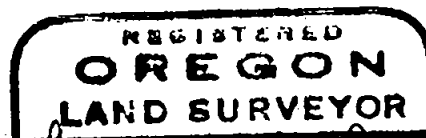

*Leland P. Lovejoy*

