

3/4" G.I.P. OR 5/8" STEEL PINS SET.  
 BEARINGS BASED ON JACKSON  
 COUNTY ROAD RECORDS.

*Edward P. Lovejoy*

BOUNDARY SURVEY  
 OF PROPERTY SITUATE IN  
 D.L.C. 47, T.38S, R.2 W.W.M.  
 JACKSON COUNTY, OREGON  
 L.P. LOVEJOY L.S. MEDFORD, ORE.  
 SCALE: 1"=200' DEC. 17, 1956

Survey Narrative to Comply With  
Section 87-330 of 1947 Oregon State Laws


Survey for: F. M. White  
Coleman Creek Road  
Medford, Oregon

Purpose of Survey: Run out property boundaries and  
subdivide.

Survey Location: D.L.C. 47, Township 38 South,  
Range 2 West, Willamette Meridian,  
Jackson County, Oregon.

Survey Procedure: Found D.L.C. corners and Jackson  
County Road Department's right-of-way  
monuments. Ran out property boundaries.

Leland P. Lovejoy  
Registered Land Surveyor  
Work completed October 16, 1956

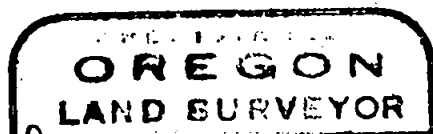

*Leland P. Lovejoy*

A rectangular stamp with rounded corners. The text inside reads "NOVEMBER 15, 1949", "LELAND P. LOVEJOY", and "262".