


SURVEY IN SEC. 27, T. 37 S. R. 1 W. W. M.
 FOR
JOHN WESTERLUND ESTATE

BY L. P. LOVEJOY
 MEDFORD, OREG.
 SEPT. 14, 1956

SCALE 1" = 200'
 1" PIPES = \circ
 5/8" PINS = \bullet

Note: Bearings determined by Solar

 

D. L. C. 58

D. L. C. 59

D. L. C. 61

Survey Narrative to Comply With
Section 87-330 of 1947 Oregon State Laws

Survey for: John Westerlund Estate
Medford, Oregon

Purpose of Survey: Run out property boundaries.

Survey Location: Section 27, Township 37 South,
Range 1 West, Willamette Meridian,
Jackson County, Oregon.

Survey Procedure: Found monuments as indicated and ran
out property boundaries, setting 3/4" galvanized iron pipe as shown on map.

Leland P. Lovejoy
Registered Land Surveyor
Work completed November 3, 1956

