

NOTE:
 Bearings based on solar observation
 North this survey equals N 1° 35' 00" E Oregon
 State Highway Dept records
 • Indicates iron pin found
 o Indicates iron pipe set

BOUNDARY LOCATION
 PROPERTY SITUATE IN
 DLC 44 T38S R1W WM
 JACKSON COUNTY OREGON
 LELAND P LOVEJOY LAND SURVEYOR
 MEDFORD OREGON 31 AUGUST 1956
 SCALE - 1" = 100'



OREGON
 LAND SURVEYOR
 LELAND P LOVEJOY
 LICENSE NO. 223

Edward P. Lovejoy

Survey Narrative to Comply With
Section 87-330 of 1947 Oregon State Laws


Survey for: Blunt, Blunt and Brackenbury
South Pacific Highway
Medford, Oregon

Purpose of Survey: Run out property boundaries.

Survey Location: D.L.C. 44, Township 38 South, Range 1
West, Willamette Meridian, Jackson
County, Oregon.

Survey Procedure: Found D.L.C. corners and State Highway
right-of-way monuments as shown. Ran
out property boundaries.

Leland P. Lovejoy
Registered Land Surveyor
Work completed November 15, 1956

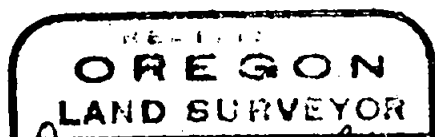

Leland P. Lovejoy

