

SE 1/4 OF SW 1/4  
OF SE 1/4

SW 1/4 OF SE 1/4  
#4D OF SE 1/4  
#5D

#3D #2D #1D

BOUNDARY LOCATION  
PROPERTY SITUATE IN  
SE 1/4 SEC 17 & NE 1/4 SEC 20  
T 37 S R 2 W WM  
JACKSON COUNTY OREGON  
L P LOVEJOY LAND SURVEYOR  
MEDFORD OREGON 7 APRIL 1953  
REV FEB. 26, 1957  
SCALE: 1" = 100'

OREGON  
LAND SURVEYOR  
*Leland P. Lovejoy*  
NOVEMBER 16, 1948  
LELAND P. LOVEJOY  
262



Survey Narrative to Comply WithSection 87-330 of 1947 Oregon State Laws


**Survey for:** Scott Darby  
Ross Lane  
Medford, Oregon

**Purpose of Survey:** Subdivide a portion of the Southwest Quarter (1/4) of the Southeast Quarter (1/4) of the Southeast Quarter (1/4) and the Southeast Quarter (1/4) of the Southwest Quarter (1/4) of the Southeast Quarter (1/4) into five tracts.

**Survey Location:** Southeast Quarter (1/4) of Section 17, Township 37 South, Range 2 West, Willamette Meridian, Jackson County, Oregon.

**Survey Procedure:** Found corners as shown on map. Set 3/4" galvanized iron pipe as indicated.

Leland P. Lovejoy  
Registered Land Surveyor  
Work completed February 28, 1957

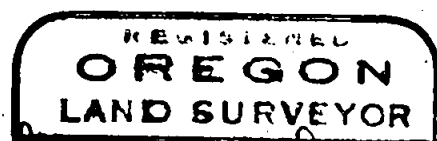

*Leland P. Lovejoy*

